

CODED
CODED

PRENTISS
640
8-18-69

MISSISSIPPI
BOARD OF WATER COMMISSIONERS
416 North State Street
Jackson, Mississippi 39201

WATER WELL DRILLERS LOG

8-18 1969 Bonds Well Drilling Prentiss
date well completed firm name county well located

LANDOWNER: Freda Jennie

description of formations encountered	from	to
Red sand	0	16
blue clay	16	120
water sand	120	160

Brownville
(mailing address)

WELL LOCATION:
sec. 23 T 5 N R 8 E
8 miles East of Brownville
(distance) (direction) (nearest town)

WELL PURPOSE: Home
(home, irrigation, municipal, industrial)


- WELL COMPLETION DATA:
- (1) diameter (inches) 4
 - (2) total depth (feet) 160
 - (3) static water level (feet) 48 ^{below} above top of ground.
 - (4) casing Steel, 21
(material) (depth)
— if telescope see back.
(size)
 - (5) screen none
(length) (depth to top)
(size) (material)
 - (6) pump 3/4 5
(HP) (yield gpm)
Electric
(type power)
 - (7) electric log no
(yes or no)
(organization running log)
 - (8) how well bottom plugged open

DRILLERS REMARKS:

SEP 2 1969
MISSISSIPPI
WATER BOARD

If well telescopes please sketch and show depths.

GROUND LEVEL

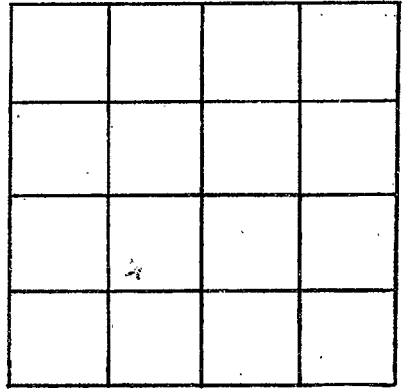

SECTION _____

Please indicate well location X.

ADDITIONAL INFORMATION

If more than one screen, show locations of each on sketch.