

PRENTISS
 G 41
 8-20-69

MISSISSIPPI
 BOARD OF WATER COMMISSIONERS
 416 North State Street
 Jackson, Mississippi 39201

CODED

WATER WELL DRILLERS LOG

8-20 1969 Bonds Well Drilling Prentiss
 date well completed firm name county well located

LANDOWNER: Wagner Vene...

| Description of formations encountered | from to | |
|---------------------------------------|------------|------------|
| | | |
| <u>Red clay</u> | <u>0</u> | <u>15</u> |
| <u>sandy blue clay</u> | <u>15</u> | <u>135</u> |
| <u>Water sand</u> | <u>135</u> | <u>180</u> |

Boonewell
 (mailing address)

WELL LOCATION:
 sec. 34 T. 5 N R. 8 E
8 miles East of Boonewell
 (distance) (direction) (nearest town)

WELL PURPOSE: Home
 (home, irrigation, municipal, industrial)

WELL COMPLETION DATA:


- (1) diameter (inches) 4
- (2) total depth (feet) 180
- (3) static water level (feet) 81 below top of ground.
- (4) casing Steel 21
 (material) (depth)
- if telescope see back.
 (size)
- (5) screen none
 (length) (depth to top)
- (size) (material)
- (6) pump installed on pump
 (HP) (yield/gpm)
- (type power)
- (7) electric log no
 (yes or no)
- (organization running log)
- (8) how well bottom plugged open

DRILLERS REMARKS:

SEP - 2 1969
 MISSISSIPPI BOARD OF WATER COMMISSIONERS

If well telescopes please sketch and show depths.

GROUND LEVEL

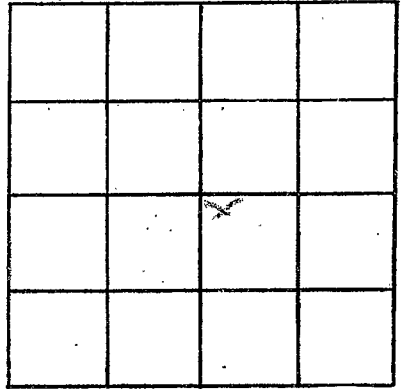

SECTION _____

Please indicate well location X.

ADDITIONAL INFORMATION

If more than one screen, show locations of each on sketch.