

Prentiss
G. 42
3-26-70

MISSISSIPPI
BOARD OF WATER COMMISSIONERS
416 North State Street
Jackson, Mississippi 39201

CODED

WATER WELL DRILLERS LOG

3-26 1970 Bonnie Well Drillers Location
date well completed firm name county well located

LANDOWNER: Francis Taylor

description of formations encountered	depth	
	from	to
<u>fine sand</u>	0	16
<u>med. sand</u>	16	115
<u>blue clay</u>	115	170
<u>water 2.0</u>	170	210

Bonnieville
(mailing address)

WELL LOCATION:
sec. 26 T. 5 N. R. 8 E.
10 miles East of Bonnieville
(distance) (direction) (nearest town)

WELL PURPOSE: Home
(home, irrigation, municipal, industrial)

WELL COMPLETION DATA:

- (1) diameter (inches) 4
- (2) total depth (feet) 210
- (3) static water level (feet) 105 below/above top of ground.
- (4) casing Steel 126
(material) (depth)
(size) if telescope see back.
- (5) screen none
(length) (depth to top)
(size) (material)
- (6) pump Hood on pump
(HP) (yield gpm)
(type power)
- (7) electric log no
(yes or no)
(organization running log)
- (8) how well bottom plugged open

CODED


APR 13 1970

DRILLERS REMARKS:

MISS. Bd. of
WATER COMMISSIONERS

If well telescopes please sketch and show depths.

GROUND LEVEL

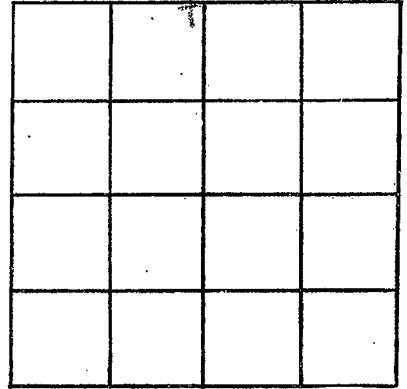

SECTION _____

Please indicate well location X.

ADDITIONAL INFORMATION

If more than one screen,
show locations of each on sketch.