

PRENTISS
G 44
8-14-70

MISSISSIPPI
BOARD OF WATER COMMISSIONERS
416 North State Street
Jackson, Mississippi 39201

WATER WELL DRILLERS LOG

CODED

8-14 date well completed 1970 Bonh Well Drilling, Prentiss firm name county well located

LANDOWNER: Leary Handell

description of formations encountered	from	to
Red clay	0	38
Sand & Blue	38	98
Black clay	98	236
White sand	236	300

Brownville Miss.
(mailing address)

WELL LOCATION:
sec. 7 T. 5 N R. 8 E
5 miles N-E of Brownville
(distance) (direction) (nearest town)

WELL PURPOSE: Dom
(home, irrigation, municipal, industrial)

WELL COMPLETION DATA:

- (1) diameter (inches) 4
- (2) total depth (feet) 300
- (3) static water level (feet) 142 below above top of ground.
- (4) casing Steel, 105
(material) (depth)
(size) If telescope see back.
- (5) screen none
(length) (depth to top)
(size) (material)
- (6) pump 2 5
(HP) (yield gpm)
Electric Jet
(type power)
- (7) electric log no
(yes or no)
(organization running log)
- (8) how well bottom plugged Open

CODED


DRILLERS REMARKS:

SEP 9 1970

MISS. BD. OF
WATER COMMISSIONERS

If well telescopes please sketch and show depths.

GROUND LEVEL

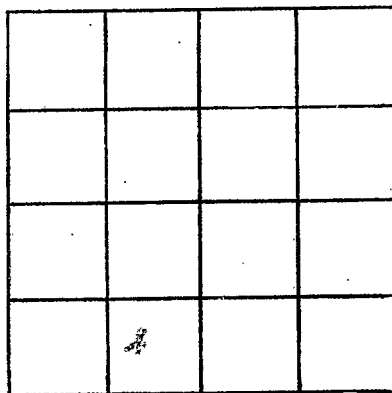

SECTION _____

Please indicate well location X.

ADDITIONAL INFORMATION

If more than one screen, show locations of each on sketch.