

MISSISSIPPI
 BOARD OF WATER COMMISSIONERS
 416 North State Street
 Jackson, Mississippi 39201

CODED

WATER WELL DRILLERS LOG

PRENTISS
G 46
8-14-70

8-14 19 70 Glendon Homan, Inc Prentiss
 date well completed firm name county well located

LANDOWNER Johnny White
Route 6
Booneville, Miss
 (mailing address)

description of formations encountered	from	to
<u>Surface sand & clay</u>	<u>0</u>	<u>33</u>
<u>Sh. clay</u>	<u>33</u>	<u>60</u>
<u>Sand</u>	<u>60</u>	<u>160</u>
<u>Bitum</u>	<u>160</u>	

WELL LOCATION:
 sec. 30 T. 5 N. R. 8 E.
3 miles SE of Booneville
 (distance) (direction) (nearest town)

WELL PURPOSE: Home
 (home, irrigation, municipal, industrial)

- WELL COMPLETION DATA:
- (1) diameter (inches) 5"
 - (2) total depth (feet) 160'
 - (3) static water level (feet) 80' below top of ground.
 - (4) casing Steel 36'9"
 (material) (depth)
8.5" if telescope see back.
 (size)
 - (5) screen 70
 (length) (depth to top)
 (size) (material)
 - (6) pump 1
 (HP) (yield gpm)
Electric
 (type power)
 - (7) electric log no
 (yes or no)
 (organization running log)
 - (8) how well bottom plugged open

CODED


OCT 12 1970

DRILLERS REMARKS:

MISS. Bd. of
 WATER COMMISSIONERS

If well telescopes please sketch and show depths.

GROUND LEVEL

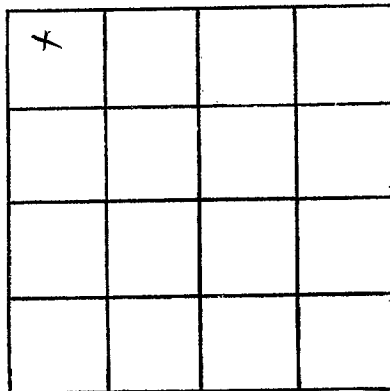

SECTION 30

Please indicate well location X.

ADDITIONAL INFORMATION

If more than one screen,
show locations of each on sketch.