

PRENTISS
G 48
3-26-71

MISSISSIPPI
BOARD OF WATER COMMISSIONERS
416 North State Street
Jackson, Mississippi 39201

CODED

WATER WELL DRILLERS LOG

3-26 date well completed 1971 Bonds Well Drilling firm name Prentiss county well located

LANDOWNER: Kenny Bonnell
Bonnelle Miss
(mailing address)

| description of formations encountered | from to | |
|---------------------------------------|---------|------|
| | feet | feet |
| Red clay | 0 | 10 |
| Blue sand | 10 | 52 |
| Bluem clay | 52 | 124 |
| Water sand | 124 | 170 |

WELL LOCATION:
sec. 28 T. 5 N R. 8 E
8 1/2 miles East of Bonnelle
(distance) (direction) (nearest town)

WELL PURPOSE: Home
(home, irrigation, municipal, industrial)

- WELL COMPLETION DATA:
- (1) diameter (inches) 4
 - (2) total depth (feet) 170
 - (3) static water level (feet) 30 below above top of ground.
 - (4) casing Steel 163
(material) (depth)
(size) if telescope see back.
 - (5) screen None
(length) (depth to top)
(size) (material)
 - (6) pump 1 7
(HP) (yield gpm)
Elect pump
(type power)
 - (7) electric log no
(yes or no)
(organization running log)
 - (8) how well bottom plugged open

CODED


APR 6 1971

MISS. BD. OF
WATER COMMISSIONERS

DRILLERS REMARKS:

If well telescopes please sketch and show depths.

GROUND LEVEL

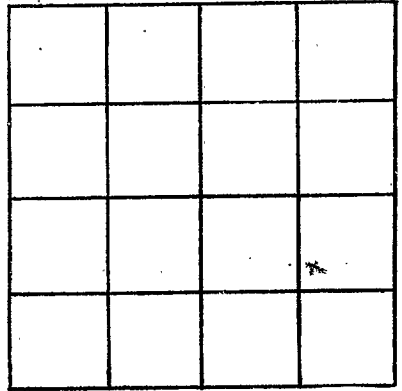

SECTION _____

Please indicate well location X.

ADDITIONAL INFORMATION

If more than one screen, show locations of each on sketch.