

PRENTISS  
G 99  
3-31-71

MISSISSIPPI  
BOARD OF WATER COMMISSIONERS  
416 North State Street  
Jackson, Mississippi 39201

**CODED**

WATER WELL DRILLERS LOG

3-31 1971 Bond Well Drilling Prentiss  
date well completed firm name county well located

LANDOWNER: Edmond Ware  
Brownville Miss  
(mailing address)

| description of formations encountered | from       | to         |
|---------------------------------------|------------|------------|
| <u>Red Clay</u>                       | <u>0</u>   | <u>34</u>  |
| <u>Blue Clay</u>                      | <u>34</u>  | <u>220</u> |
| <u>Water sand</u>                     | <u>220</u> | <u>270</u> |

WELL LOCATION:  
sec. 18 T. 5 N R. 8 E  
5 miles East of Brownville  
(distance) (direction) (nearest town)

WELL PURPOSE: Home  
(home, irrigation, municipal, industrial)

- WELL COMPLETION DATA:
- (1) diameter (inches) 4
  - (2) total depth (feet) 270
  - (3) static water level (feet) 110 below above top of ground.
  - (4) casing Steel 42  
(material) (depth)  
(size) If telescope see back.
  - (5) screen none  
(length) (depth to top)  
(size) (material)
  - (6) pump 2 5  
(HP) (yield gpm)  
Electric  
(type power)
  - (7) electric log no  
(yes or no)  
(organization running log)
  - (8) how well bottom plugged open

**CODED**


APR -6 1971

DRILLERS REMARKS:

MISS. Bd. of  
WATER COMM.

If well telescopes please sketch and show depths.

GROUND LEVEL

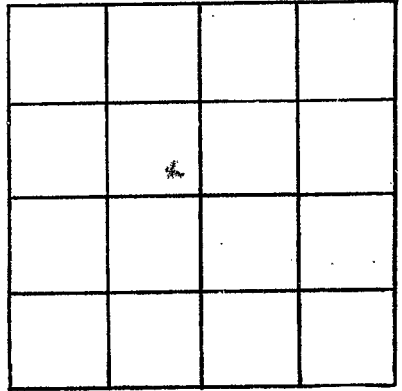

SECTION \_\_\_\_\_

Please indicate well location X.

ADDITIONAL INFORMATION

If more than one screen, show locations of each on sketch.