

PRENTISS
G50
4-6-71

MISSISSIPPI
BOARD OF WATER COMMISSIONERS
416 North State Street
Jackson, Mississippi 39201

CODED

WATER WELL DRILLERS LOG

4-6-71 1971 *Bond Well Drilling* PRENTISS
date well completed firm name county well located

LANDOWNER: *William McKenney*
Bonville Miss.
(mailing address)

description of formations encountered	from	to
<i>Red clay</i>	<i>0</i>	<i>18</i>
<i>Blue clay</i>	<i>18</i>	<i>116</i>
<i>Water sand</i>	<i>116</i>	<i>166</i>

WELL LOCATION:
sec. *19* T. *5* N R. *8* E
3 miles *East* of *Bonville*
(distance) (direction) (nearest town)

WELL PURPOSE: *Home*
(home, irrigation, municipal, industrial)

- WELL COMPLETION DATA:
- (1) diameter (inches) *4*
 - (2) total depth (feet) *166*
 - (3) static water level (feet) *42* below above
top of ground.
 - (4) casing *Steel*, *21*
(material) (depth)
 if telescope see back.
(size)
 - (5) screen *None*
(length) (depth to top)
 (size) (material)
 - (6) pump (HP) (yield gpm)
Had on pump
(type power)
 - (7) electric log *Yes*
(yes or no)
 (organization running log)
 - (8) how well bottom plugged *open*

CODED


MAY 10 1971

MISS. BD. OF
WATER COMMISSIONERS

DRILLERS REMARKS:

If well telescopes please sketch and show depths.

GROUND LEVEL

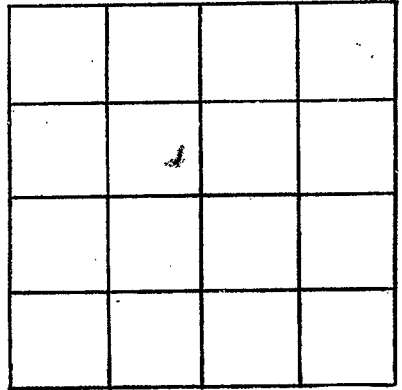

SECTION _____

Please indicate well location X.

ADDITIONAL INFORMATION

If more than one screen, show locations of each on sketch.