

Prentiss

G-54

7-22-71

MISSISSIPPI BOARD OF WATER COMMISSIONERS
416 North State Street
Jackson, Mississippi 39201

CODED

WATER WELL DRILLERS LOG

7-22

date well completed

1971 Bond Well Drilling

firm name

Prentiss

county well located

LANDOWNER: Kay Beard

description of formations encountered

from

to

Boonville Miss
(mailing address)

Red clay
Blue clay
Water sand

0 16
16 83
83 129

WELL LOCATION:

sec. 24 T 5 N R 8 E

1/4 miles East of Boonville
(distance) (direction) (nearest town)

WELL PURPOSE:

(home, irrigation, municipal, industrial) None

WELL COMPLETION DATA:

CODED

(1) diameter (inches) 4
(2) total depth (feet) 129
(3) static water level (feet) 160 below top of ground.

(4) casing Steel 21
(material) (depth)

(size) if telescope see back.

(5) screen none
(length) (depth to top)

(size) (material)

(6) pump Hand on pump
(HP) (yield gpm)
(type power)

(7) electric log no
(yes or no)

(organization running log)

(8) how well bottom plugged open


AUG 11 1971

DRILLERS REMARKS:

MISS. BD. OF
WATER COM.

If well telescopes please sketch and show depths.

GROUND LEVEL

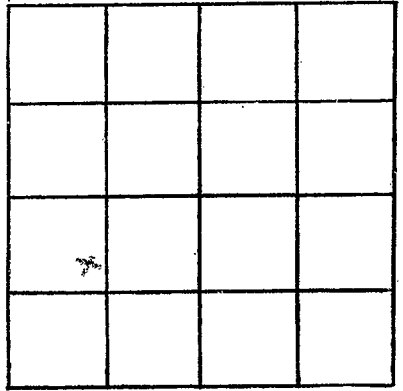

SECTION _____

Please indicate well location X.

ADDITIONAL INFORMATION

If more than one screen, show locations of each on sketch.