

Prentiss
 G-55
 7-27-71

MISSISSIPPI
 BOARD OF WATER COMMISSIONERS
 416 North State Street
 Jackson, Mississippi 39201

CODED

WATER WELL DRILLERS LOG

7-27 1971 *Bonds Well Drilling* *Prentiss*
 date well completed firm name county well located

LANDOWNER: *Jr. Beard*
Boonerville Miss
 (mailing address)

description of formations encountered	from	to
<i>Red clay</i>	<i>0</i>	<i>17</i>
<i>Yellow sand</i>	<i>17</i>	<i>56</i>
<i>Blue clay</i>	<i>56</i>	<i>216</i>
<i>Water sand</i>	<i>210</i>	<i>250</i>

WELL LOCATION:
 sec. *8* T. *5* N. R. *8* E
8 miles *East* of *Boonerville*
 (distance) (direction) (nearest town)

WELL PURPOSE: *Home*
 (home, irrigation, municipal, industrial)

- WELL COMPLETION DATA:
- (1) diameter (inches) *4*
 - (2) total depth (feet) *250*
 - (3) static water level (feet) *58* below above top of ground.
 - (4) casing *Steel*, *68*
 (material) (depth)
 (size) If telescope see back.
 - (5) screen *None*
 (length) (depth to top)
 (size) (material)
 - (6) pump *Hand on pump*
 (HP) (yield gpm)
 (type power)
 - (7) electric log *no*
 (yes or no)
 (organization running log)
 - (8) how well bottom plugged *open*

CODED


AUG 11 1971

MISS. Bd. of
 WATER COMMISSIONERS

DRILLERS REMARKS:

If well telescopes please sketch and show depths.

GROUND LEVEL

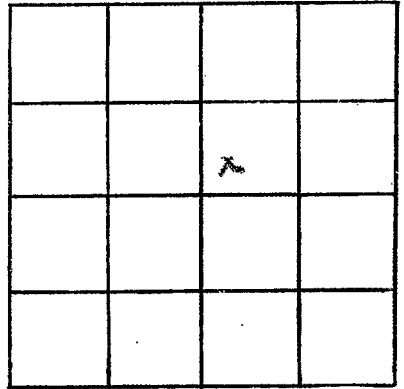

SECTION _____

Please indicate well location X.

ADDITIONAL INFORMATION

If more than one screen, show locations of each on sketch.