

MISSISSIPPI
BOARD OF WATER COMMISSIONERS
416 North State Street
Jackson, Mississippi 39201

CODED

PRENTISS
G60
9-29-72

WATER WELL DRILLERS LOG

9-29 1972 Bond Well Drilling Prentiss
date well completed firm name county well located

LANDOWNER: Renton Gunn description of formations encountered from to
Barnwell Miss (mailing address) Red clay 0 35
Water sand 146 200
Blue clay 35 146

WELL LOCATION:
 sec. 30 T. 5 N R. 8 E
5 miles East of Barnwell
 (distance) (direction) (nearest town)

WELL PURPOSE: Home
 (home, irrigation, municipal, industrial)

- WELL COMPLETION DATA:
- (1) diameter (inches) 4
 - (2) total depth (feet) 200
 - (3) static water level (feet) 70 below above top of ground.
 - (4) casing Steel 42
 (material) (depth)
 (size) if telescope see back.
 - (5) screen none
 (length) (depth to top)
 (size) (material)
 - (6) pump 1 1/2 6
 (HP) (yield gpm)
jet pump
 (type power)
 - (7) electric log no
 (yes or no)
 (organization running log)
 - (8) how well bottom plugged open

CODED


UPT 17 1972

MISS. ST. OF WATER COMMISSIONERS

DRILLERS REMARKS:

If well telescopes please sketch and show depths.

GROUND LEVEL

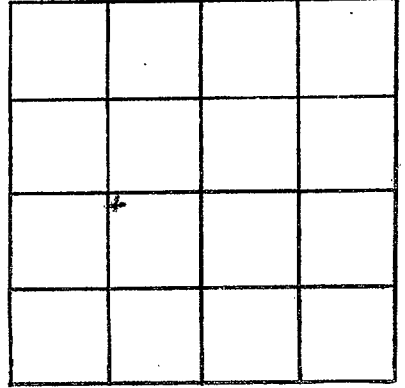

SECTION _____

Please indicate well location X.

ADDITIONAL INFORMATION

If more than one screen,
show locations of each on sketch.