

PRENTISS
G 62
5-23-73

MISSISSIPPI
 BOARD OF WATER COMMISSIONERS
 416 North State Street
 Jackson, Mississippi 39201

CODED

WATER WELL DRILLERS LOG

5-23 1973 Bonds Well Drilling Prentiss
 date well completed firm name county well located

LANDOWNER: Tommy Brewer

description of formations encountered

from to

Boonville, Miss.
 (mailing address)

<u>Red clay</u>	<u>0</u>	<u>20</u>
<u>Blue clay</u>	<u>20</u>	<u>110</u>
<u>Water Sand</u>	<u>140</u>	<u>150</u>

WELL LOCATION:
 sec. 26 T. 5 N R. 8 E
 (S) W
8 miles East of Boonville
 (distance) (direction) (nearest town)

WELL PURPOSE: None
 (home, irrigation, municipal, industrial)

WELL COMPLETION DATA:

- (1) diameter (inches) 4
- (2) total depth (feet) 150
- (3) static water level (feet) 22 below above top of ground.
- (4) casing steel, 21
 (material) (depth)
 _____ If telescope see back.
 (size)
- (5) screen None
 (length) (depth to top)
 _____ (size) _____ (material)
- (6) pump Head on Pump
 (HP) (yield gpm)
 _____ (type power)
- (7) electric log No
 (yes or no)
 _____ (organization running log)
- (8) how well bottom plugged Open


CODED

DRILLERS REMARKS:

JUN 6 1973

If well telescopes please sketch and show depths.

GROUND LEVEL

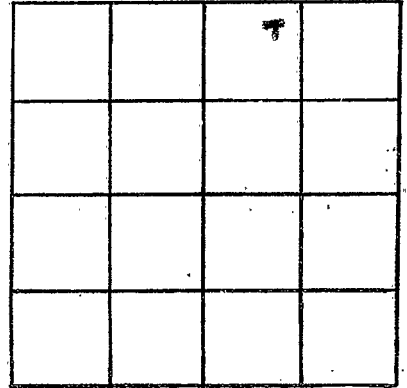

SECTION _____

Please indicate well location X.

ADDITIONAL INFORMATION

If more than one screen,
show locations of each on sketch.