

PRENTISS

G63

6-1-73

MISSISSIPPI BOARD OF WATER COMMISSIONERS
416 North State Street
Jackson, Mississippi 39201

CODED

WELL WELL DRILLERS LOG

6-1-1973 Bonds Well Drilling Prentiss
date well completed firm name county well located

LANDOWNER: Kylie Moulard

Booneville, Miss.

(mailing address)

WELL LOCATION:

sec. 36 T. 5 N R. 8 E
S W

10 miles E of Booneville
(distance) (direction) (nearest town)

WELL PURPOSE: Home
(home, irrigation, municipal, industrial)

WELL COMPLETION DATA:

- (1) diameter (inches) 4
- (2) total depth (feet) 150
- (3) static water level (feet) 80 below above top of ground.
- (4) casing Steel, 84'
(material) (depth)

_____ If telescope see back.
(size)

- (5) screen None
(length) (depth to top)

_____ (size) (material)

- (6) pump 1 1/2 5
(HP) (yield gpm)
- jet
(type power)

- (7) electric log no
(yes or no)

_____ (organization running log)

- (8) how well bottom plugged open

description of formations encountered

from

to

Red clay	0	18
yellow sand	18	78
Blue clay	78	110
Water Sand	110	150


CODED

DRILLERS REMARKS:

JUL 5 1973

If well telescopes please sketch and show depths.

GROUND LEVEL

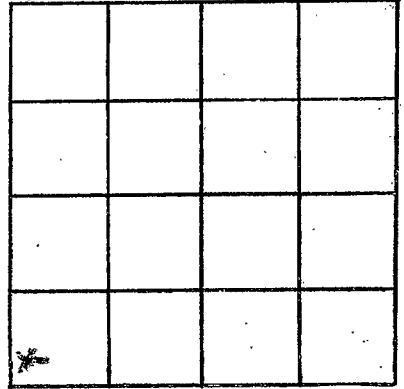

SECTION 36

Please indicate well location X.

ADDITIONAL INFORMATION

If more than one screen, show locations of each on sketch.