

PRENTISS

G 64

6-15-73

MISSISSIPPI  
 BOARD OF WATER COMMISSIONERS  
 416 North State Street  
 Jackson, Mississippi 39201

**CODED**

WATER WELL DRILLERS LOG

6-15 1973  
date well completed

Bonds Well Drilling  
firm name

Prentiss  
county well located

LANDOWNER: Mike Green

Booneville, Miss.

(mailing address)

WELL LOCATION:

sec. 11 T 5 N R 8 E  
9 miles E of Booneville  
 (distance) (direction) (nearest town)

WELL PURPOSE: Home  
 (home, irrigation, municipal, industrial)

WELL COMPLETION DATA:

- (1) diameter (inches) 4
- (2) total depth (feet) 194
- (3) static water level (feet) 70 <sup>below</sup>/<sub>above</sub> top of ground.
- (4) casing Steel, 21'  
 (material) (depth)  
 \_\_\_\_\_ if telescope see back.  
 (size)
- (5) screen None  
 (length) (depth to top)  
 \_\_\_\_\_  
 (size) (material)
- (6) pump headon pump  
 (HP) (yield gpm)  
 \_\_\_\_\_  
 (type power)
- (7) electric log NO  
 (yes or no)  
 \_\_\_\_\_  
 (organization running log)
- (8) how well bottom plugged open

description of formations encountered

from

to

<u>Red clay</u>	<u>0</u>	<u>17</u>
<u>Blue clay</u>	<u>17</u>	<u>147</u>
<u>Water sand</u>	<u>147</u>	<u>194</u>


**CODED**

DRILLERS REMARKS:

JUN 5 1973

If well telescopes please sketch and show depths.

GROUND LEVEL

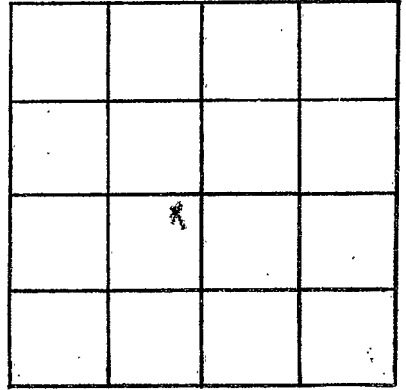

SECTION 11

Please indicate well location X.

ADDITIONAL INFORMATION

If more than one screen,  
show locations of each on sketch.