

Prentiss
667
228-74

MISSISSIPPI
BOARD OF WATER COMMISSIONERS
416 North State Street
Jackson, Mississippi 39201

CODED

WATER WELL DRILLERS LOG

2-28
date well completed

1974 Bonds Well Drilling
firm name

Prentiss
county well located

LANDOWNER: Jerry Kiddle
Booneville, Miss.
(mailing address)

description of formations encountered	from	to
	Red clay	0
Blue clay	35	160
Water sand	160	215

WELL LOCATION:
sec. 32 T. 5 N R. 8 E
9 miles East of Booneville
(distance) (direction) (nearest town)

CODED

WELL PURPOSE: Home
(home, irrigation, municipal, industrial)

- WELL COMPLETION DATA:
- (1) diameter (inches) 4"
 - (2) total depth (feet) 215
 - (3) static water level (feet) 80 ^{below} above top of ground.
 - (4) casing Steel, 42,
(material) (depth)
(size) if telescope see back.
 - (5) screen none
(length) (depth to top)
(size) (material)
 - (6) pump 1 1/2 5
(HP) (yield gpm)
Jack
(type) (power)
 - (7) electric log no
(yes or no)
(organization running log)
 - (8) how well bottom plugged open


DRILLERS REMARKS:

DECEMBER 1974

JUN 26 1974

If well telescopes please sketch and show depths.

GROUND LEVEL

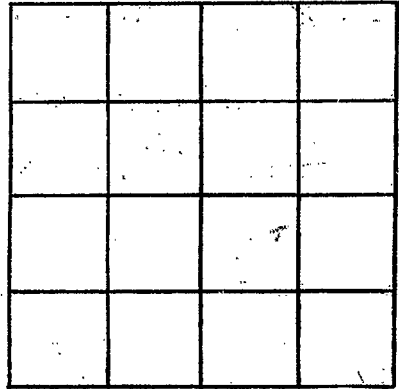

SECTION _____

Please indicate well location X.

ADDITIONAL INFORMATION

If more than one screen, show locations of each on sketch.