

Prentiss  
 G 68  
 8-15-74

MISSISSIPPI  
 BOARD OF WATER COMMISSIONERS CODED  
 416 North State Street  
 Jackson, Mississippi 39201

WATER WELL DRILLERS LOG

8-15 1974 Bond Well Drilling Prentiss  
 date well completed firm name county well located

LANDOWNER: Donald Rowland  
Bronville, Miss.  
 (mailing address)

description of formations encountered	from	to
Red clay	0	32
Blue clay	32	136
Water Sand	136	170

WELL LOCATION:  
 sec. 9 T. 5 N R. 8 E  
6 miles E of Bronville  
 (distance) (direction) (nearest town)

WELL PURPOSE: Home  
 (home, irrigation, municipal, industrial)


- WELL COMPLETION DATA:
- (1) diameter (inches) 4"
  - (2) total depth (feet) 170'
  - (3) static water level (feet) 55 <sup>below</sup> above top of ground.
  - (4) casing Steel, 35'  
 (material) (depth)  
 (size) if telescope see back.
  - (5) screen None  
 (length) (depth to top)  
 (size) (material)
  - (6) pump 1 1/2 50  
 (HP) (yield gpm)  
Jet  
 (type power)
  - (7) electric log NO  
 (yes or no)  
 (organization running log)
  - (8) how well bottom plugged open

DRILLERS REMARKS:

RECEIVED  
 OCT - 1 1974

If well telescopes please sketch and show depths.

GROUND LEVEL

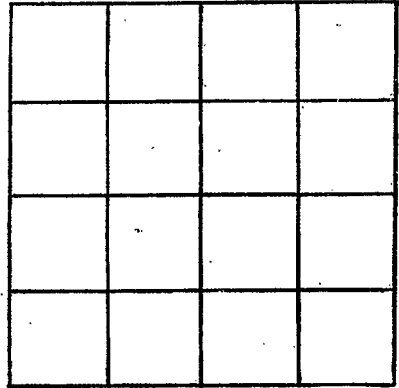

SECTION \_\_\_\_\_

Please indicate well location X.

ADDITIONAL INFORMATION

If more than one screen, show locations of each on sketch.