

Prentiss
 669
 8-14-74

MISSISSIPPI
 BOARD OF WATER COMMISSIONERS
 416 North State Street
 Jackson, Mississippi 39201

CODED

WATER WELL DRILLERS LOG

8-14 date well completed 1974 Bonds Well Drilling firm name Prentiss county well located

LANDOWNER: Freddie Akers
Booneville, Miss
 (mailing address)

description of fomations encountered	from	to
	Red clay	0
Sandy Blue	32	76
Blue Clay	76	153
Water Sand	153	195

WELL LOCATION:
 sec. 26 T. 5 N. R. 8 E
8 1/2 miles E of Booneville
 (distance) (direction) (nearest town)

WELL PURPOSE: Home
 (home, irrigation, municipal, industrial)


- WELL COMPLETION DATA:
- (1) diameter (inches) 4"
 - (2) total depth (feet) 195'
 - (3) static water level (feet) 60 ^{below} _{above} top of ground.
 - (4) casing Steel, 80'
 (material) (depth)
 _____ If telescope see back.
 (size)
 - (5) screen None
 (length) (depth to top)
 _____ (size) _____ (material)
 - (6) pump 3/4 10
 (HP) (yield gpm)
Sub
 (type power)
 - (7) electric log NO
 (yes or no)
 _____ (organization running log)
 - (8) how well bottom plugged open

DRILLERS REMARKS:

REGISTERED
 10/1/74
 MISS. BD. OF WATER COMMISSIONERS

If well telescopes please sketch and show depths.

GROUND LEVEL

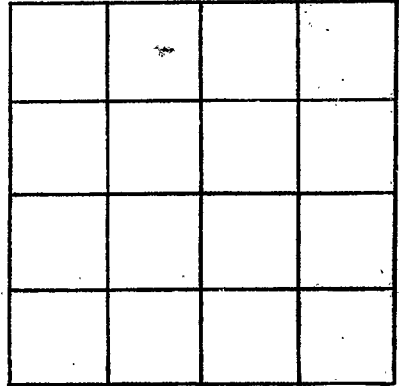

SECTION _____

Please indicate well location X.

ADDITIONAL INFORMATION

If more than one screen, show locations of each on sketch.