

**PRENTISS**  
**G 4870**  
**11-6-74**

MISSISSIPPI  
 BOARD OF WATER COMMISSIONERS  
 416 North State Street  
 Jackson, Mississippi 39201

**CODED**

**WATER WELL DRILLERS LOG**

11-6 1974 Bonds Well Drilling Prentiss  
 date well completed firm name county well located


LANDOWNER: <u>Billy Simmon</u> <u>Bonnaville</u>	description of formations encountered	from	to
<u>Miss</u> (mailing address)	<u>Red Clay</u> <u>Blue Clay</u> <u>Water Sand</u>	<u>0</u> <u>15</u> <u>150</u>	<u>15</u> <u>150</u> <u>190</u>
<b>WELL LOCATION:</b> sec <u>22</u> T <u>5</u> N R <u>8</u> (E) <sup>13B</sup> (S) (W) <u>8</u> miles <u>E</u> of <u>Bonnaville</u> (distance) (direction) (nearest town)			
<b>WELL PURPOSE:</b> <u>Home</u> (home, irrigation, municipal, industrial)			
<b>WELL COMPLETION DATA:</b>			
(1) diameter (inches) <u>4"</u>			
(2) total depth (feet) <u>190</u>			
(3) static water level (feet) <u>84</u> <sup>below</sup> <sub>above</sub> top of ground.			
(4) casing <u>Steel</u> <u>18</u> (material) (depth)			
(size) If telescope see back.			
(5) screen <u>None</u> (length) (depth to top)			
(size) (material)			
(6) pump <u>1/2</u> <u>5</u> (HP) (yield gpm)			
<u>Jet</u> (type power)			
(7) electric log <u>NO</u> (yes or no)			
(organization running log)			
(8) how well bottom plugged <u>Open</u>			
<b>DRILLERS REMARKS:</b>			

**CODED**

**RECEIVED**  
**MAR 13 1975**

If well telescopes please  
sketch and show depths.

GROUND LEVEL

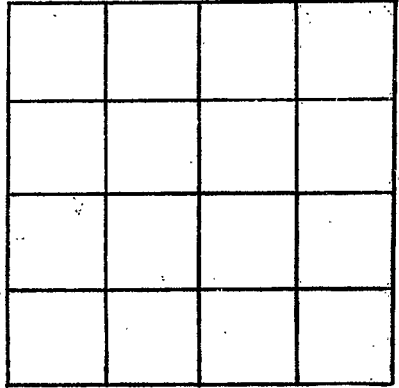

SECTION \_\_\_\_\_

Please indicate well location X.

ADDITIONAL INFORMATION

If more than one screen,  
show locations of each on sketch.