

MISSISSIPPI
BOARD OF WATER COMMISSIONERS
416 North State Street
Jackson, Mississippi 39201

WATER WELL DRILLERS LOG

Prentiss Co
G 75
7-69

7-11-1969 days well completed
 Bond Well Drilling firm name
 Prentiss county well located

LANDOWNER: <u>Melton Nuttall</u>	description of formations encountered	from	to
<u>Boonville</u> (mailing address)	<u>Yellow sand</u>	<u>0</u>	<u>38</u>
	<u>blue clay</u>	<u>38</u>	<u>190</u>
	<u>Water sand</u>	<u>190</u>	<u>250</u>

WELL LOCATION:
 sec. 8 T 5 N R 8 E
5 miles East of Boonville
 (distance) (direction) (nearest town)


WELL PURPOSE: Home
 (home, irrigation, municipal, industrial)

- WELL COMPLETION DATA:
- (1) diameter (inches) 4
 - (2) total depth (feet) 250
 - (3) static water level (feet) 100 below above top of ground.
 - (4) casing Steel 42
 (material) (depth)
 _____ if telescope see back.
 (size)
 - (5) screen none
 (length) (depth to top)

 (size) (material)
 - (6) pump 3/4 3
 (HP) (yield gpm)
jet
 (type power)
 - (7) electric log no
 (yes or no)


 (organization running log)
 - (8) how well bottom plugged opens

DRILLERS REMARKS:

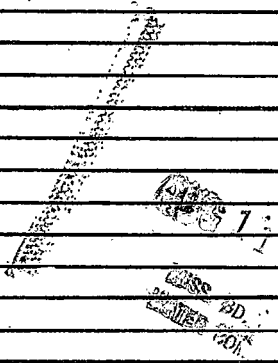

If well telescopes please sketch and show depths.

GROUND LEVEL

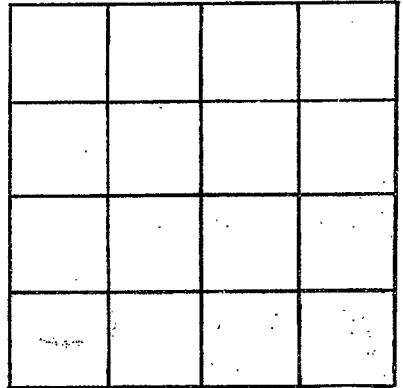

SECTION _____

Please indicate well location X.

ADDITIONAL INFORMATION

If more than one screen, show locations of each on sketch.