

# STATE WELL REPORT

## Part 1

### Driller's Log

Mississippi Department of Environmental Quality  
Office of Land and Water Resources  
P.O. Box 2309  
Jackson, MS 39225-2309  
(601)961-5210  
(601)360-0535 (fax)

County: PALENTISS CO  
Permit #: \_\_\_\_\_  
Driller: PAAMS & PAAK'S  
Date drilling completed: 12/15/13

### For Office Use Only:

Well #: 678  
Aquifer: \_\_\_\_\_  
E-Log #: \_\_\_\_\_

*State Law requires that this report be prepared by the license holder responsible for the work and filed with the Department at the above address within 30 days of completion of drilling of the well or borehole.*

Well Owner Information (Landowner if borehole is not for a water well)	Well or Borehole Location
Owner Name: <u>RUSSELL STITES</u>	Latitude: <u>34.63226</u> Longitude: <u>-88.505572</u>
Mailing Address: <u>149 CR100</u> <u>Booneville, MS 38829</u>	Method of Lat/Long (check one): Conventional Survey _____ USGS quad <input checked="" type="checkbox"/> Hand-held GPS _____ Survey-grade GPS _____
City _____ State _____ Zip Code _____	<u>SW 1/4 NW 1/4, Sec 19 T 55 R 6E</u>
Telephone No. (____) _____	<u>5</u> Miles <u>EAST</u> of <u>Booneville</u> (Distance) (Direction) (Nearest Town)

**Well / Borehole Data**

Date drilling started: 12/8/13 Date drilling completed: 12/16/13 Hole depth: 425.30 Hole diameter: 8"

Location of the source of any surface water used for drilling: \_\_\_\_\_

Method of dosing and volume of Chlorine used in drilling and development: 5 PPM

Logs run (circle all applicable):  No log run  Electric  Gamma Ray  Density  Sonic  Neutron  Other: \_\_\_\_\_

Name of organization running log(s): \_\_\_\_\_

Purpose of borehole (circle one):  Water Well  Geotechnical/Geological Investigation  Ground Source Heat Pump  
 Seismic Survey  Other (describe) \_\_\_\_\_

*If drilling is not related to water well construction, skip the remainder of this block*

Purpose of Well (circle all applicable):  Home  Industrial  Public Supply  Irrigation  Fish Culture

Other (describe): \_\_\_\_\_

If a flowing well, method of flow regulation: Valve \_\_\_\_\_ Other (describe) \_\_\_\_\_

Static Water Level: 145 feet [above or below] land surface Date measured: 12/15/13  
(circle one)

Method of measurement (circle one): Steel tape  Electric tape  Air line  Other (describe): \_\_\_\_\_

Well depth: 425 Well grouted to a depth of: 30 feet Type of grout (circle one):  Neat Cement  Bentonite  Mix

Casing length: 365 feet Casing diameter: 4" inches Type of casing: PVC

Screen length: 60 feet Screen diameter: 4" inches Type of screen: PVC

Screen slot size: 1016 inches Setting depth: From 365 feet to 425 feet

Type of completion (circle all applicable):  Gravel packed  Underreamed  Open hole  Natural Development

Other (describe): \_\_\_\_\_

Top of lap pipe or reduction in casing: \_\_\_\_\_ feet

*If telescoped or more than one screen, describe on next page*

**RECEIVED**


JAN 21 2014  
Form: OLWR-SWR-1A (4/13)

**BY: OLWR**

The sketch below only required for water wells

If well telescopes, show depths on sketch.

Ground Level →

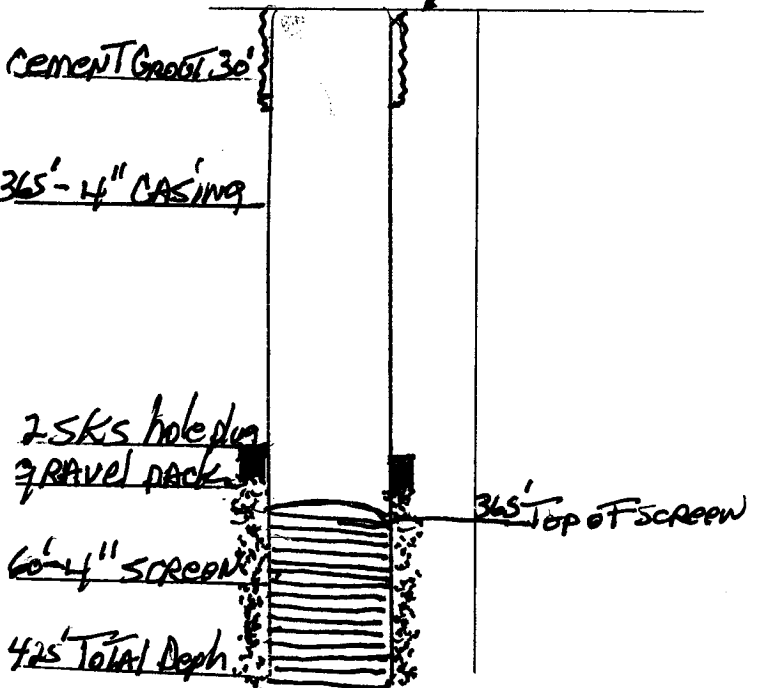

If more than one screen, show location of each on sketch

Description of formations encountered must be provided for all wells and boreholes, unless specifically exempted by regulations

Description of Formations Encountered	From (depth)	To (depth)
	Ground Level	
Red SAND	0	20
SAND + CLAY	20	105
CLAY	105	288
Rock + CLAY	288	340
SAND + GRAVEL	340	425

Sketch the property layout and include the following: 1) the well location; 2) any permanent structures on the property that may aid in locating the well; 3) any roads, power lines, or other items that may aid in locating the property and the well; 4) a north arrow.

MAP ATTACHED

Landowner Name: Russell Stites

Form: OLWR-SWR-1A (04/08)

I certify that the well/borehole was drilled, constructed, and completed in accordance with all applicable requirements of the Mississippi Department of Environmental Quality and the Mississippi Department of Health regulations, if applicable, and state laws.

Print Name of Responsible Licensee and License No. Rayburn Parks 0-414

Date 12/15/13

Signature of Licensee Rayburn Parks

RECEIVED  
JAN 21 2014

BY: OLWR

# STATE WELL REPORT

## Part 2

**Pump Installer's Completion Report**  
 Mississippi Department of Environmental Quality  
 Office of Land and Water Resources  
 P. O. Box 2309  
 Jackson, MS 39225-2309  
 (601)961-5210  
 (601) 360-0535 (fax)

County: <u>PRENTISS CO</u>
Permit #:
Driller: <u>PARKS &amp; PARKS</u>
Date completed: <u>12/15/13</u>
<i>Copy information from block on Part 1</i>

<b>For Office Use Only:</b>
Well #: <u>678</u>
Aquifer: _____

*This part of the report must be completed by a licensed water well contractor or a licensed pump installer. A copy of Part 1 of the report must be attached and both parts filed with the Department at the above address within 30 days of well completion.*

Well Owner Information	Well Location
Owner Name: <u>RUSSELL STATES</u>	Latitude: <u>34.632226</u> Longitude: <u>-88.505572</u>
Mailing Address: <u>149 CR100</u> <u>Booneville, MS 38829</u>	Method of Lat/Long (check one): Conventional Survey _____, USGS quad _____, Hand-held GPS <input checked="" type="checkbox"/> , Survey-grade GPS _____
City _____ State _____ Zip Code _____	_____ 1/4 _____ 1/4, Sec _____ T _____ R _____
Telephone No. (____) _____	<u>5</u> Miles <u>EAST</u> of <u>Booneville</u> (Distance) (Direction) (Nearest Town)

**Pump Type (circle one)**

Submersible  Turbine  Air Lift  Centrifugal  Flowing Well  Jet  Piston  Rotary  Other (describe): \_\_\_\_\_

Date Pump Installed: 12/15/13 Rated Pump Capacity: 15 Gallons Per Minute

Is This Pump (circle one):  New  Repaired  Replacement

**Power Type (circle one)**

Electric  Diesel  Gasoline  Natural Gas  Tractor PTO  Windmill  Other (describe): \_\_\_\_\_

Horse Power Rating of Motor: 1 Setting Depth: 210 feet Number of Stages: 12

**Pump Test Data for Non Flowing Well**

Date Well Tested: 12/15/13 Duration of Pump Test (minimum 4 hours): 4 hours

Static Water Level (A): 145 Feet Below Land Surface Pumping Water Level (B): 175 Feet Below Land Surface

Drawdown [(B) - (A)]: 175 Feet Below Land Surface Test Pumping Rate: 15 Gallons Per Minute

Method of measurement (circle one): Steel tape  Electric tape  Air line  Other (describe): \_\_\_\_\_

**Pump Test Data for Flowing Well**

Measured shut in head: 184 feet.

Well yielded 15 GPM with a drawdown of 30 feet after 4 hours of pumping

**Meter Installation**

Meter Manufacturer: N/A Meter Serial Number: \_\_\_\_\_

Meter Model Number/Name: \_\_\_\_\_ Type of Meter: \_\_\_\_\_

Totalizer Register Unit and Multiplier Factor (AF x .001, gal x 1000, etc): \_\_\_\_\_

Installation Date: \_\_\_\_\_ Meter installed by: \_\_\_\_\_

Is This Meter (circle one):  New  Repaired  Replacement

*Important: By submitting the above information you are certifying that this meter was installed to manufacturer standards. For agricultural wells, a list of approved meters is on the MDEQ website.*

I HEREBY CERTIFY that the above statements are true to the best of my knowledge.

Rayburn Parks 044 1/20/14 Rayburn Parks  
 Print Name of Pump Installer and License No. (if applicable) Date Signature of Pump Installer