

MISSISSIPPI BOARD OF WATER COMMISSIONERS

Prentiss  
G 2003  
10-66

WATER WELL DRILLERS LOG

Date: Oct 27, 1966, Driller: Bonds County: Prentiss

(Name)

	Description & Color of Materials Sand, Clay, Red Clay, Shell, etc.	Thick- ness Feet	Depth Feet
(1) Owner of Land: <u>Loyd Ralph</u> <u>Boonville Miss</u> (Name) (Address)	<u>yellow Sand</u>	<u>60</u>	<u>60</u>
(2) Location: <u>NE 1/4, 1/4, Sec. 7 T5 R2E</u> <u>5 miles East, Boonville</u> (distance), (direction), (Nearest Town)	<u>Sandy blue</u>	<u>190</u>	<u>250</u>
(3) Topography: <u>Hilly</u> (Hilly) (Flat) (Level)	<u>Water Sand</u>	<u>50</u>	<u>300</u>
(4) Purpose of Well: <u>Domestic</u> (Domestic Irrigation Municipal, Industrial, Other)			

Information upon completion of well:


- (1) Diameter 4 inches.
- (2) Total Depth 300 feet.
- (3) Water Level NO feet below top of ground.
- (4) Cased to 63, Size 4"
- (5) Screen: Size none, Length \_\_\_\_\_
- (6) Were any formations sealed against pollution?

\_\_\_\_\_ yes, X no.

If YES depth of formation \_\_\_\_\_

Why \_\_\_\_\_

Drillers Remarks: \_\_\_\_\_

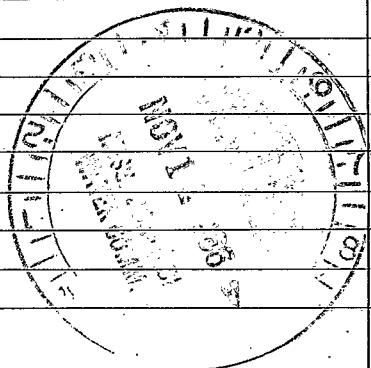

(Use Back Side)

Well No.

with

over  
and

1