

**MISSISSIPPI  
BOARD OF WATER COMMISSIONERS**  
416 North State Street  
Jackson, Mississippi 39201

**WATER WELL DRILLERS LOG**

*Prentiss*  
*G 2004*  
*1-67*

*Jan 2, 1967* 19 *Bonds Plumbing & Drilling Co.* *Prentiss*  
date well completed firm name county well located

LANDOWNER: *Archie Jackson*  
*Route 4*  
*Booneville, Miss*  
(mailing address)

WELL LOCATION:  
sec. *15* T. *5* N R. *8* E  
*8* miles *E* of *Booneville*  
(distance) (direction) (nearest town)

WELL PURPOSE: *Home*  
(home, irrigation, municipal, industrial)

WELL COMPLETION DATA:

(1) diameter (inches) *4"*

(2) total depth (feet) *200'*

(3) static water level (feet) *70'* below above top of ground.

(4) casing *1/2" Steel*, *92'*  
(material) (depth)

*4"* if telescope see back.  
(size)

(5) screen \_\_\_\_\_  
(length) (depth to top)

\_\_\_\_\_ (size) \_\_\_\_\_ (material)

(6) pump *3* *5*  
(HP) (yield gpm)

*elect.*  
(type power)


(7) electric log *no*  
(yes or no)

\_\_\_\_\_ (organization running log)

(8) how well bottom plugged *open*

description of formations encountered	from	to
<i>Red <del>clay</del> Clay</i>	<i>0</i>	<i>14</i>
<i>Yellow sand</i>	<i>14</i>	<i>20</i>
<i>Sandy Blue Clay</i>	<i>20</i>	<i>160</i>
<i>Rock</i>	<i>160</i>	<i>162.8</i>
<i>Water Sand</i>	<i>162.8</i>	<i>200</i>

DRILLERS REMARKS:

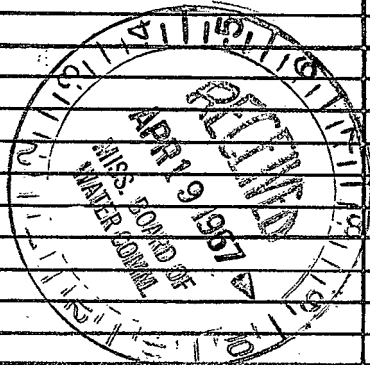

If well telescopes please sketch and show depths.

GROUND LEVEL

			X

SECTION 15

Please indicate well location X.

ADDITIONAL INFORMATION

If more than one screen, show locations of each on sketch.