

PRENTISS
6-2005
5-68

MISSISSIPPI
BOARD OF WATER COMMISSIONERS
416 North State Street
Jackson, Mississippi 39201

WATER WELL DRILLERS LOG

May 1 1968 Bonds P. Drilling Prentiss
date well completed firm name county well located

LANDOWNER: Henry Bearden
Route 4
Booneville
(mailing address)

WELL LOCATION:
sec. 8 T 5 N R 8 E
1 1/2 miles SE of Booneville
(distance) (direction) (nearest town)

WELL PURPOSE: Home
(home, irrigation, municipal, industrial)

- WELL COMPLETION DATA:
- (1) diameter (inches) 4
 - (2) total depth (feet) 280
 - (3) static water level (feet) 85' below top of ground.
 - (4) casing Steel 42' (material) (depth)
~~iron~~ if telescope see back.
(size)
 - (5) screen none
(length) (depth to top)
none
(size) (material)
 - (6) pump 3/4 (HP) 5 1/2 (yield gpm)
Elect Jet
(type power)
 - (7) electric log none
(yes or no)
none
(organization running log)
 - (8) how well bottom plugged Open


description of formations encountered	from	to
Sandy Clay	0	22
Shale	22	40
Blue Clay	41	160
Rock	160	162 1/2
Sandy Blue	163	189
Rock	189	190 1/2
Water Sand in layers	191	280

MAY 23 1968
MISS. Bd. of WATER COMMISSIONERS

DRILLERS REMARKS:

If well telescopes please sketch and show depths.

GROUND LEVEL

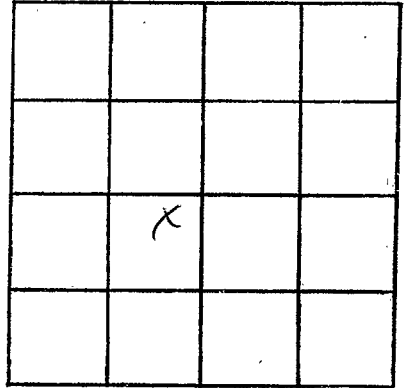

SECTION 8

Please indicate well location X.

ADDITIONAL INFORMATION

Lined area for additional information.

If more than one screen, show locations of each on sketch.