

**MISSISSIPPI
BOARD OF WATER COMMISSIONERS**
416 North State Street
Jackson, Mississippi 39201

WATER WELL DRILLERS LOG

Prentiss
G 2004
5-68

May 22 1968 Booneville Plat. Drilling Prentiss
date well completed firm name county well located

LANDOWNER: Ellis Shackelford description of formations encountered

	from	to
<u>Route 5</u>	<u>0</u>	<u>18</u>
<u>Booneville</u>	<u>18</u>	<u>25</u>
(mailing address)	<u>25</u>	<u>32</u>
	<u>32</u>	<u>70</u>
	<u>70</u>	<u>130</u>

WELL LOCATION:
sec. 24 5 N R. 4 E
8 miles E of Booneville
(distance) (direction) (nearest town)

WELL PURPOSE: Home
(home, irrigation, municipal, industrial)

WELL COMPLETION DATA:


- (1) diameter (inches) 4"
- (2) total depth (feet) 130
- (3) static water level (feet) 22 below top of ground.
- (4) casing Steel 32
(material) (depth)
4"
(size) If telescope see back.
- (5) screen none
(length) (depth to top)
(size) (material)
- (6) pump 1/2 5
(HP) (yield gpm)
Elect
(type power)
- (7) electric log no
(yes or no)
(organization running log)
- (8) how well bottom plugged Open

MAY 28 1968
MISS. BD. OF
WATER COMM.

DRILLERS REMARKS:

If well telescopes please sketch and show depths.

GROUND LEVEL

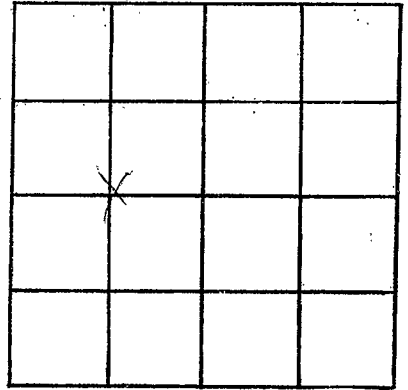

SECTION 24

Please indicate well location X.

ADDITIONAL INFORMATION

If more than one screen,
show locations of each on sketch.