

PRENTISS

G 2007

4-23-76

MISSISSIPPI BOARD OF WATER COMMISSIONERS
416 North State Street
Jackson, Mississippi 39201

WATER WELL DRILLERS LOG

4-23 1976 Bonds Well Drilling Prentiss
date well completed firm name county well located


LANDOWNER: <u>Max Johnson</u> <u>Booneville</u>	description of formations encountered	from	to
(mailing address)	Red Clay	0	15
WELL LOCATION:	Yellow Sand	15	90
sec. <u>T 5 N</u> R. <u>8 E</u> <u>8</u> miles <u>E</u> of <u>Booneville</u> (distance) (direction) (nearest town)	Blue Clay	90	280
WELL PURPOSE: <u>Home</u> (home, irrigation, municipal, industrial)	Water	280	302
WELL COMPLETION DATA:			
(1) diameter (inches) <u>4"</u>			
(2) total depth (feet) <u>302'</u>			
(3) static water level (feet) <u>180</u> <u>below</u> above top of ground.			
(4) casing <u>Plastic</u> , <u>100'</u> (material) (depth)			
_____ If telescope see back. (size)			
(5) screen <u>no</u> (length) (depth to top)			
_____ (size) _____ (material)			
(6) pump <u>3/4</u> <u>10 gpm</u> (HP) (yield gpm)			
<u>elect.</u> (type power)			
(7) electric log <u>no</u> (yes or no)			
_____ (organization running log)			
(8) how well bottom plugged <u>open</u>			
DRILLERS REMARKS:			

RECEIVED
DEC - 7 1976

MISS. BD. OF WATER COMMISSIONERS

If well telescopes please sketch and show depths.

GROUND LEVEL

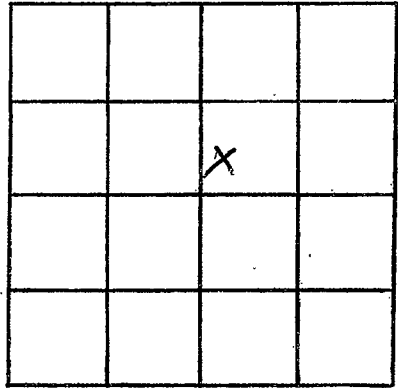

SECTION _____

Please indicate well location X.

ADDITIONAL INFORMATION

If more than one screen, show locations of each on sketch.