

PRENTISS

G 2008

12-23-77

MISSISSIPPI BOARD OF WATER COMMISSIONERS 416 North State Street Jackson, Mississippi 39201

WATER WELL DRILLERS LOG

12-23 1977 Bonds Well Drilling Prentiss date well completed firm name county well located

LANDOWNER: Junior McAnally

description of formations encountered

from

to

Boneville

Red Clay

0 10

Yellow Sand

10 35

Blue Clay

35 120

Water Sand

120 185

(mailing address)

WELL LOCATION:

sec. 32 T. 5 N R. 8 E

6 miles SE of Boneville (distance) (direction) (nearest town)

WELL PURPOSE: Home (home, irrigation, municipal, industrial)

WELL COMPLETION DATA:

- (1) diameter (inches) 4"
(2) total depth (feet) 185
(3) static water level (feet) 60 below top of ground.
(4) casing Plastic, 40 (material) (depth)

(size) If telescope see back.

- (5) screen no (length) (depth to top)

(size) (material)

- (6) pump 3/4 (HP) 10 gpm (yield gpm)


elect (type power)

- (7) electric log no (yes or no)

(organization running log)

- (8) how well bottom plugged open

DRILLERS REMARKS:

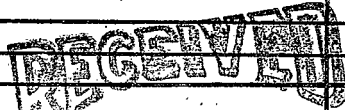


DEC - 5 1978

MISS. BD. OF WATER COMMISSIONERS

If well telescopes please sketch and show depths.

GROUND LEVEL

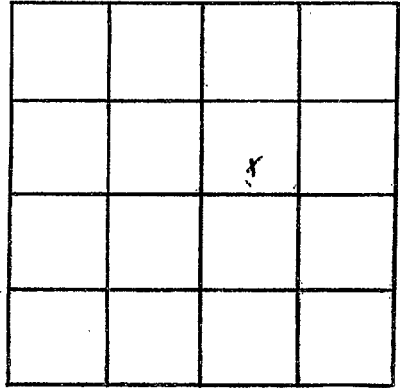

SECTION \_\_\_\_\_

Please indicate well location X.

ADDITIONAL INFORMATION

If more than one screen,  
show locations of each on sketch.