

PRENTISS

G 200A

10-23-78

MISSISSIPPI BOARD OF WATER COMMISSIONERS 416 North State Street Jackson, Mississippi 39201

WATER WELL DRILLERS LOG

10-23 1978 Bond Well Drilling Prentiss date well completed firm name county well located

LANDOWNER: Chester Smith Booneville (mailing address) WELL LOCATION: sec. 32 T. 5 N. R. 8 E. 6 miles SE of Booneville (distance) (direction) (nearest town) WELL PURPOSE: None (home, irrigation, municipal, industrial) WELL COMPLETION DATA: (1) diameter (inches) 4" (2) total depth (feet) 172' (3) static water level (feet) 60 below top of ground (4) casing Plastic 40' (material) (depth) (size) If telescope see back. (5) screen no (length) (depth to top) (size) (material) (6) pump 1 1/2 (HP) 5 gpm (yield gpm) select (type power) (7) electric log no (yes or no) (organization running log) (8) how well bottom plugged open DRILLERS REMARKS:


Table with 3 columns: description of formations encountered, from, to. Rows include Red Clay, Yellow Sand, Blue Clay, and Water Seal.

RECEIVED DEC 5 1978

MISS. BD. OF WATER COMM

If well telescopes please sketch and show depths.

GROUND LEVEL

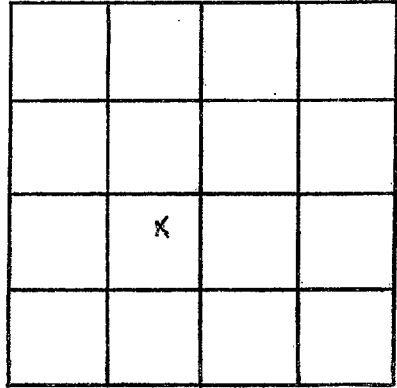

SECTION _____

Please indicate well location X.

ADDITIONAL INFORMATION

If more than one screen,
show locations of each on sketch.