

PRENTISS

G 2010

8-25-78

MISSISSIPPI BOARD OF WATER COMMISSIONERS
416 North State Street
Jackson, Mississippi 39201

WATER WELL DRILLERS LOG

8-25 1978 Bonds Well Drilling Prentiss
date well completed firm name county well located

LANDOWNER: Curtis Fusterson

Booneville

(mailing address)

description of formations encountered

from to

Red Clay	0	10
Yellow sand	10	15
Blue Clay	15	150
Water sand	150	215

WELL LOCATION:

sec. 23 T. 5 N R. 8 E
S W
5 miles W of Booneville
(distance) (direction) (nearest town)

WELL PURPOSE: Home
(home, irrigation, municipal, industrial)

WELL COMPLETION DATA:

- (1) diameter (inches) 4"
- (2) total depth (feet) 215
- (3) static water level (feet) 60 below top of ground.
- (4) casing Plastic, 20 (material) (depth)
(size) If telescope see back.
- (5) screen no (length) (depth to top)
(size) (material)
- (6) pump 1/2 5 gpm (HP) (yield gpm)
elect (type power)
- (7) electric log no (yes or no)
(organization running log)
- (8) how well bottom plugged open

DRILLERS REMARKS:


RECEIVED

DEC - 5 1978

MISS. BD. OF WATER COMMISSIONERS

If well telescopes please sketch and show depths.

GROUND LEVEL

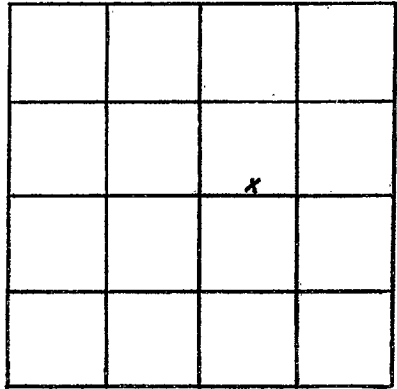

SECTION _____

Please indicate well location X.

ADDITIONAL INFORMATION

If more than one screen,
show locations of each on sketch.