

PRENTISS

G 2011

8-31-78

MISSISSIPPI BOARD OF WATER COMMISSIONERS 416 North State Street Jackson, Mississippi 39201

WATER WELL DRILLERS LOG

8-31 1978 Bond Well Drilling Prentiss date well completed firm name county well located

LANDOWNER: A.V. Murphy

Bon Booneville

(mailing address)

description of formations encountered

from to

Red Clay 0 10 Yellow Sand 10 35 Blue Clay 35 160 Water Sand 160 215

WELL LOCATION:


sec 32 T 5 N R 8 E 6 miles SE of Booneville (distance) (direction) (nearest town)

WELL PURPOSE: Home (home, irrigation, municipal, industrial)

WELL COMPLETION DATA:

- (1) diameter (inches) 4" (2) total depth (feet) 215 (3) static water level (feet) 90 below top of ground. (4) casing Plastic 40 (material) (depth) (size) if telescope see back. (5) screen no (length) (depth to top) (size) (material) (6) pump 1/2 500m (HP) (yield gpm) electric (type power) (7) electric log no (yes or no) (organization running log) (8) how well bottom plugged open

DRILLERS REMARKS:

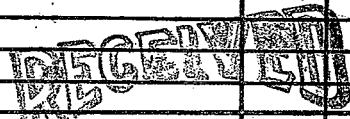


DEC - 5 1978

MISS. Bd. OF WATER COMMISSIONERS

If well telescopes please sketch and show depths.

GROUND LEVEL

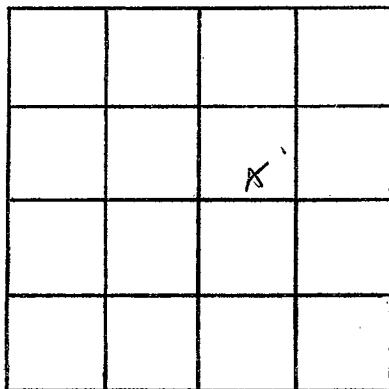

SECTION \_\_\_\_\_

Please indicate well location X.

ADDITIONAL INFORMATION

If more than one screen,  
show locations of each on sketch.