

PRENTISS  
G 2013  
11/20/80

MISSISSIPPI  
BOARD OF WATER COMMISSIONERS  
416 North State Street  
Jackson, Mississippi 39201

WATER WELL DRILLERS LOG

11-20-80 date well completed 19 Bonds Well Drilling firm name Prentiss county well located

LANDOWNER: Gene Tompison  
Bronoville, MS.  
(mailing address)

description of formations encountered	from	to
0-90 Red clay		
90-155 Blue clay		
155-194 Water sand		

WELL LOCATION:  
sec. 22 T. 5 N. R. 8 E  
8 miles E of Bronoville  
(distance) (direction) (nearest town)

WELL PURPOSE: none  
(home, irrigation, municipal, industrial)

WELL COMPLETION DATA:  
(1) diameter (inches) 4"  
(2) total depth (feet) 194  
(3) static water level (feet) 80 below top of ground.  
(4) casing (material) Presti (depth) 100'  
(size) If telescope see back.  
(5) screen (length) (depth to top)  
(size) (material)  
(6) pump 3/4 (HP) 10 (yield gpm)  
Elec. (type power)  
(7) electric log NO (yes or no)  
(organization running log)

(8) how well bottom plugged open

DRILLERS REMARKS:


DEPT. OF NATURAL RESOURCES  
BUREAU OF LAND & WATER RESOURCES

MAY 19 1981

RECEIVED

If well telescopes please sketch and show depths.

GROUND LEVEL

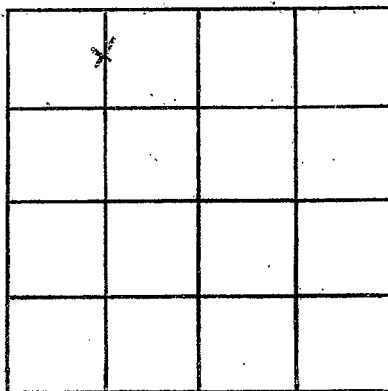

SECTION \_\_\_\_\_

Please indicate well location X.

ADDITIONAL INFORMATION

If more than one screen, show locations of each on sketch.