

PRENTISS

G 2014

10-28-81

MISSISSIPPI BOARD OF WATER COMMISSIONERS
416 North State Street
Jackson, Mississippi 39201

WATER WELL DRILLERS LOG

10-28
date well completed

1981 Bonds Well Drilling
firm name

Prentiss
county well located

LANDOWNER: Jimmy Hutchens
Booneville, MS

description of formations encountered

from

to

Red clay
water sand

0

50

50

86

(mailing address)

WELL LOCATION:

sec. 5 T 5 N R 8 E
8 miles East of Booneville
(distance) (direction) (nearest town)

WELL PURPOSE: home
(home, irrigation, municipal, industrial)

WELL COMPLETION DATA:

- (1) diameter (inches) 4"
- (2) total depth (feet) 86
- (3) static water level (feet) 30 below top of ground.
- (4) casing Plastic, 86 (material) (depth)

(size) If telescope see back.

- (5) screen Perforated (length) (depth to top)

4" Gravel (size) (material)

- (6) pump had own (HP) (yield gpm)

(type power)

- (7) electric log (yes or no)

(organization running log)

- (8) how well bottom plugged plugged

DEPT. OF NATURAL RESOURCES
BUREAU OF LAND & WATER RESOURCES


NOV 10 1981

DRILLERS REMARKS:

RECEIVED

If well telescopes please sketch and show depths.

GROUND LEVEL

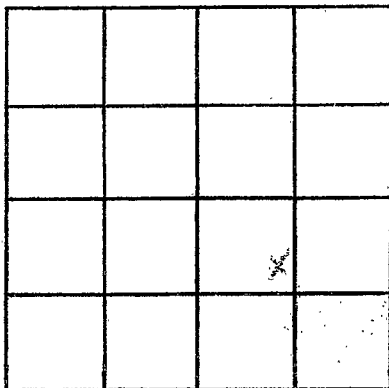

SECTION _____

Please indicate well location X.

ADDITIONAL INFORMATION

NOV 10 8:41
O
F
E
D

If more than one screen, show locations of each on sketch.