

PRENTISS  
H 16  
12-19-72

MISSISSIPPI  
BOARD OF WATER COMMISSIONERS  
416 North State Street  
Jackson, Mississippi 39201

WATER WELL DRILLERS LOG

CODED

12-19 1972 Bonds Well Drilling & Rentals  
date well completed firm name county well located

LANDOWNER: Royal Taylor

description of formations encountered from to

Boonerville Miss.  
(mailing address)

Red clay	0	17
Yellow sand	17	32
Blue clay	32	54
Water sand	54	148

WELL LOCATION:  
sec. 27 T 5 N R 9 E  
12 miles East of Boonerville  
(distance) (direction) (nearest town)

WELL PURPOSE: Home  
(home, irrigation, municipal, industrial)

WELL COMPLETION DATA:

- (1) diameter (inches) 4
- (2) total depth (feet) 148
- (3) static water level (feet) 62 below above top of ground.
- (4) casing Steel, 148 (material) (depth)
- (size) If telescope see back. 20
- (5) screen Perforated casing (length) (depth to top)
- (size) (material)
- (6) pump 3/4 (HP) 4 (yield gpm)
- Elect (type power)
- (7) electric log no (yes or no)
- (organization running log)
- (8) how well bottom plugged plugged


CODED

FEB 5 1973

DRILLERS REMARKS:

If well telescopes please sketch and show depths.

GROUND LEVEL

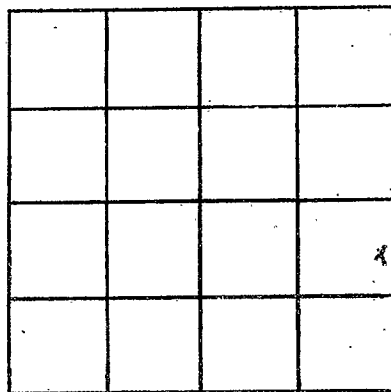

SECTION \_\_\_\_\_

Please indicate well location X.

ADDITIONAL INFORMATION

If more than one screen, show locations of each on sketch.