

Prentiss  
 H 18  
 5-1-74

MISSISSIPPI  
 BOARD OF WATER COMMISSIONERS  
 416 North State Street  
 Jackson, Mississippi 39201


CODED

WATER WELL DRILLERS LOG

5-1 date well completed      1974 Bondwell Drilling firm name      Prentiss county well located

LANDOWNER:	description of formations encountered	from	to
Tom Harger Booneville, Miss. (mailing address)	Red clay Red sand Water Sand	0 35 90	35 90 146
WELL LOCATION: sec 27 T 5 N R 9 E 1.7 miles East of Booneville (distance) (direction) (nearest town)			
WELL PURPOSE: home (home, irrigation, municipal, industrial)			
WELL COMPLETION DATA:			
(1) diameter (inches) 4"			
(2) total depth (feet) 146			
(3) static water level (feet) 55 below above top of ground.			
(4) casing Plastic 146 / 26 (material) (depth)			
(size) If telescope see back.			
(5) screen Perforated Pipe (length) (depth to top)			
4 Plastic (size) (material)			
(6) pump 3/4 10 (HP) (yield gpm)			
Submersible (type power)			
(7) electric log NO (yes or no)			
(organization running log)			
(8) how well bottom plugged Plugged			
DRILLERS REMARKS:			

CODED

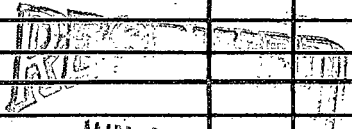


JAN 20 1974

MISSISSIPPI BOARD OF WATER COMMISSIONERS

If well telescopes please sketch and show depths.

GROUND LEVEL

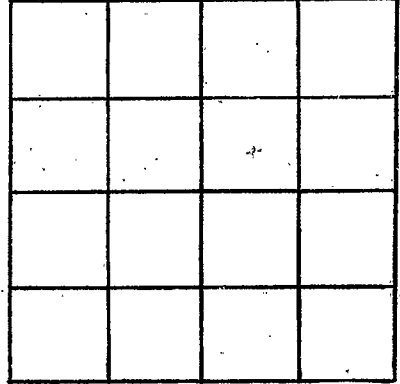

SECTION \_\_\_\_\_

Please indicate well location X.

ADDITIONAL INFORMATION

A series of horizontal lines for providing additional information, starting below the 'ADDITIONAL INFORMATION' header and extending to the bottom of the page.

If more than one screen, show locations of each on sketch.