

Prentiss  
H 19  
6-4-74

MISSISSIPPI  
BOARD OF WATER COMMISSIONERS  
416 North State Street  
Jackson, Mississippi 39201

CODED

WATER WELL DRILLERS LOG

6-4 date well completed      1974 Bonds Well Drilling firm name      Prentiss county well located

LANDOWNER: Melvin Jackson  
Booneville, Miss.  
(mailing address)

| description of formations encountered | from     | to  |
|---------------------------------------|----------|-----|
|                                       | Red clay | 0   |
| Red sand                              | 40       | 85  |
| Water sand                            | 85       | 120 |

WELL LOCATION:  
sec. 31 T. 5 N. R. 9 E  
15 miles East of Booneville  
(distance) (direction) (nearest town)

WELL PURPOSE: home  
(home, irrigation, municipal, industrial)

CODED

- WELL COMPLETION DATA:
- (1) diameter (inches) 4"
  - (2) total depth (feet) 120
  - (3) static water level (feet) 40 <sup>below</sup> <sub>above</sub> top of ground.
  - (4) casing Plastic, 120,  
(material) (depth)  
(size) if telescope see back.
  - (5) screen Perforated Pipe  
(length) (depth to top)  
4", Plastic  
(size) (material)
  - (6) pump 3/4 10  
(HP) (yield gpm)  
Sub.  
(type power)
  - (7) electric log no  
(yes or no)  
(organization running log)
  - (8) how well bottom plugged plugged


DRILLERS REMARKS:

RECEIVED  
JUL 26 1974

MISS. BD. OF WATER COMMISSIONERS

If well telescopes please sketch and show depths.

GROUND LEVEL

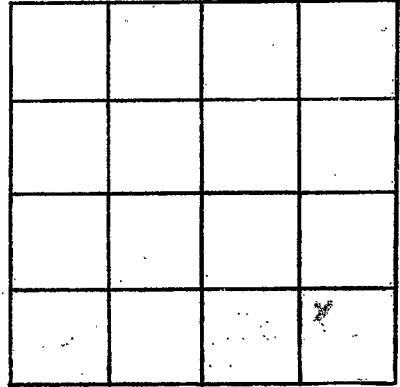

SECTION \_\_\_\_\_

Please indicate well location X.

ADDITIONAL INFORMATION

If more than one screen, show locations of each on sketch.