

Prentiss
H 20
5-13-74

MISSISSIPPI
 BOARD OF WATER COMMISSIONERS
 416 North State Street
 Jackson, Mississippi 39201

WATER WELL DRILLERS LOG

CODED

5-13 date well completed 1974 Bondwell Drilling firm name Prentiss county well located

LANDOWNER: J. C. Greene
Bonneville, Miss.
 (mailing address)


description of formations encountered	from	to
<u>Red clay</u>	<u>0</u>	<u>45</u>
<u>Red sand</u>	<u>45</u>	<u>70</u>
<u>water sand</u>	<u>70</u>	<u>126</u>

WELL LOCATION:
 sec. 27 T. 5 N. R. 9 E.
17 miles East of Bonneville
 (distance) (direction) (nearest town)

WELL PURPOSE: Home
 (home, irrigation, municipal, industrial)

CODED

- WELL COMPLETION DATA:
- (1) diameter (inches) 4"
 - (2) total depth (feet) 126
 - (3) static water level (feet) 55 ^{below} above top of ground.
 - (4) casing Plastic, 126, 106
 (material) (depth)
 (size) If telescope see back.
 - (5) screen Perforated pipe
 (length) (depth to top)
4", Plastic
 (size) (material)
 - (6) pump 3/4 10
 (HP) (yield gpm)
sub.
 (type power)
 - (7) electric log no
 (yes or no)
 - (8) how well bottom plugged flushed

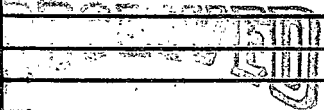


JUN 26 1974

DRILLERS REMARKS:

MISS. DE. OF WATER COMM.

If well telescopes please sketch and show depths.

GROUND LEVEL

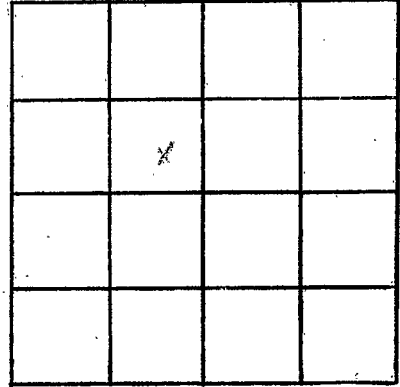

SECTION _____

Please indicate well location X.

ADDITIONAL INFORMATION

If more than one screen, show locations of each on sketch.