

Prentiss
H 21
5-8-74

MISSISSIPPI
BOARD OF WATER COMMISSIONERS
416 North State Street
Jackson, Mississippi 39201

CODED

WATER WELL DRILLERS LOG

5-8 1974 Bonds Well Drilling Prentiss
date well completed firm name county well located

LANDOWNER: E. N. Whitehead
Bonneville, Miss.
(mailing address)

description of formations encountered	from	to
Red clay	0	40
Red Sand	40	85
Water Sand	85	120

WELL LOCATION:
sec. 31 T 5 N R 9 E
15 miles East of Bonneville
(distance) (direction) (nearest town)

CODED

WELL PURPOSE: Home
(home, irrigation, municipal, industrial)

WELL COMPLETION DATA:

(1) diameter (inches) 4"

(2) total depth (feet) 120

(3) static water level (feet) 40 ^{below} above top of ground.

(4) casing Plastic, 120
(material) (depth)
(size) If telescope see back.


(5) screen Perforated Pipe
(length) (depth to top)
4" Plastic
(size) (material)

(6) pump 3/4 10
(HP) (yield gpm)
Submersible
(type power)

(7) electric log No
(yes or no)

(organization running log)

(8) how well bottom plugged Plugged

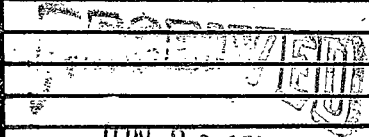


JUN 28 1974

DRILLERS REMARKS:

MISSISSIPPI BOARD OF WATER COMMISSIONERS

If well telescopes please sketch and show depths.

GROUND LEVEL

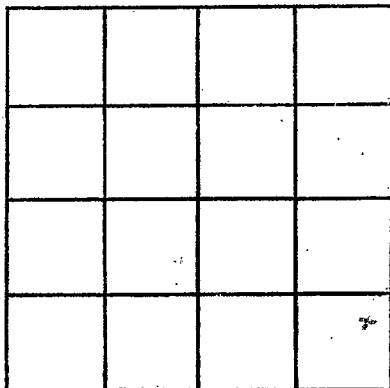

SECTION _____

Please indicate well location X.

ADDITIONAL INFORMATION

If more than one screen, show locations of each on sketch.