

PRENTISS

H 2000

4-14-78

MISSISSIPPI BOARD OF WATER COMMISSIONERS
416 North State Street
Jackson, Mississippi 39201

WATER WELL DRILLERS LOG

4-14 1978 Bondo Well Drilling Prentiss
date well completed firm name county well located

LANDOWNER: Prentiss Rhimes

Booneville

(mailing address)

description of formations encountered

from

to

Red Clay

0

20

Yellow sand

20

70

Water sand

70

130

WELL LOCATION:

sec 21 T 5 N R 9 E
9 miles E of Booneville
(distance) (direction) (nearest town)

WELL PURPOSE: Home
(home, irrigation, municipal, industrial)

WELL COMPLETION DATA:

- (1) diameter (inches) 4"
- (2) total depth (feet) 130
- (3) static water level (feet) 70 below above top of ground.
- (4) casing Plastic, 130
(material) (depth)

(size) If telescope see back.

- (5) screen Perforated
(length) (depth to top)

(size) (material)

- (6) pump 3/4 10 gpm
(HP) (yield gpm)

elect.
(type power)

- (7) electric log no
(yes or no)

(organization running log)

- (8) how well bottom plugged plugged


DRILLERS REMARKS:

RECEIVED
DEC - 5 1978

MISS. BD. OF WATER COMMISSIONERS

If well telescopes please sketch and show depths.

GROUND LEVEL

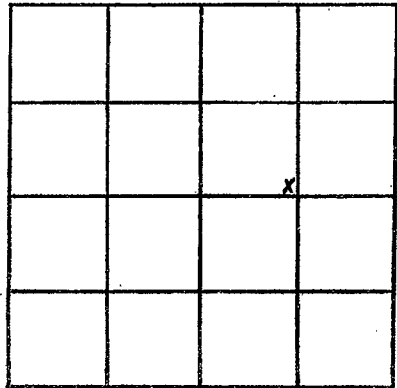

SECTION _____

Please indicate well location X.

ADDITIONAL INFORMATION

If more than one screen,
show locations of each on sketch.