

DA 7/11/69

Prentiss
J
6-5-69

MISSISSIPPI
BOARD OF WATER COMMISSIONERS
416 North State Street
Jackson, Mississippi 39201

CODED

WATER WELL DRILLERS LOG

6-5 1969 date well completed
Banks Well Drilling firm name
Prentiss county well located

LANDOWNER: James Bellis

description of formations encountered	from	to
Yellow sand	0	16
Blue Clay	16	365
Water sand	365	435

Baldwin (mailing address)


WELL LOCATION:
sec. 10 T-6 N R-6 E
6 miles West of Frank Jordan (nearest town)

WELL PURPOSE: Home (home, irrigation, municipal, industrial)

- WELL COMPLETION DATA:
- (1) diameter (inches) 4
 - (2) total depth (feet) 435
 - (3) static water level (feet) 140 below top of ground.
 - (4) casing Steel, 21 (material) (depth)
 - (size) if telescope see back.
 - (5) screen none (length) (depth to top)
 - (size) (material)
 - (6) pump Jet, 4 gal (HP) (yield gpm)
 - (type power)
 - (7) electric log No (yes or no)
 - (organization running log)
 - (8) how well bottom plugged Open


DRILLERS REMARKS:

JUL 11 1969

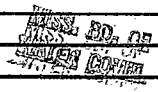

If well telescopes please sketch and show depths.

GROUND LEVEL

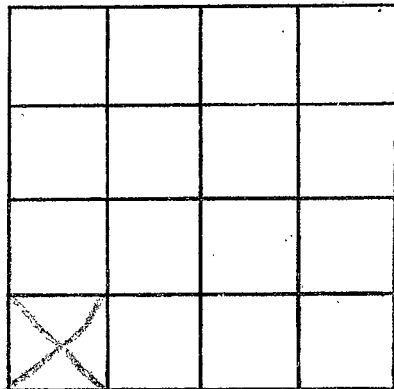

SECTION 10

Please indicate well location X.

ADDITIONAL INFORMATION

If more than one screen,
show locations of each on sketch.