

PRENTISS MISSISSIPPI BOARD OF WATER COMMISSIONERS

J 68

1965

WATER WELL DRILLERS LOG

Date: 1965, Driller: Herndon-Homan Well & Supply, Inc. County Prentiss

P. O. Box 42

County Prentiss

E Log 21

SHANNON, MISSISSIPPI 38960

(1) Owner of Land: <u>Town of Baldwyn</u> (Name)	Description & Color of Materials Sand, Clay, Red Clay, Shell, etc.	Thick- ness Feet	Depth Feet
<u>Baldwyn, Miss</u> (Address)	<u>red clay</u>		<u>0-9</u>
(2) Location: <u>1/4, 1/4, Sec. 35 T. 69 N. R. 10 E.</u>	<u>white chalk (soft)</u>	<u>9-16</u>	
_____ miles: _____, of <u>Baldwyn</u> (distance) (direction) (Nearest Town)	<u>Blue clay</u>	<u>16-33</u>	
(3) Topography: <u>Flat</u> (Hilly) (Flat) (Level)	<u>hard water</u>	<u>33-50</u>	
(4) Purpose of Well: <u>Municipal</u> (Domestic Irrigation Municipal, Industrial, Other)	<u>Blue clay (streaks sand)</u>	<u>54-71</u>	
	<u>Blue clay</u>	<u>71-125</u>	
	<u>Hard Rock</u>	<u>125-126</u>	
	<u>Blue clay</u>	<u>126-237</u>	
	<u>Sandy blue clay</u>	<u>237-245</u>	
	<u>hard water</u>	<u>245-245.8</u>	
	<u>Blue clay</u>	<u>245.8-284</u>	

Information upon completion of well:


- (1) Diameter 6 inches.
- (2) Total Depth 420 feet.
- (3) Water Level 46' feet below top of ground.
- (4) Cased to 300', Size 10".
- (5) Screen: Size 6", Length 70'.
- (6) Were any formations sealed against pollution?
 yes, _____ no.

If YES depth of formation 20'

Why crains quoted

Drillers Remarks:

<u>Hard water</u>	<u>245-245.8</u>	
<u>Blue clay</u>	<u>245.8-284</u>	
<u>sand tight</u>	<u>284-342</u>	
<u>Shale</u>	<u>342-346</u>	
<u>sand streaks shale</u>	<u>346-392</u>	
<u>Shale + sand (Good)</u>	<u>392-465</u>	
<u>sand (Good)</u>	<u>465-490</u>	
<u>Bottom of test</u>		

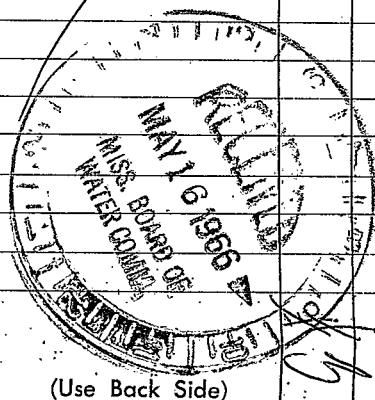

(Use Back Side)

Well No. 101

①