

CODED

MISSISSIPPI BOARD OF WATER COMMISSIONERS  
416 North State Street  
Jackson, Mississippi 39201

WATER WELL DRILLERS LOG

Prentiss  
J 71  
3-26-69

March 26 1969 J. W. Webb & Sons Prentiss  
date well completed firm name county well located

LANDOWNER:

description of formations encountered from to

Eugene Cot  
Baldwin, Miss  
(mailing address)

Clay 0 12  
Blue mud 12 45  
Water sand 45 180  
Water sand & blue mud 180 220

WELL LOCATION:

sec. 20 T 6 N R 6 E  
S #  
4 miles West of Baldwin  
(distance) (direction) (nearest town)

WELL PURPOSE: home  
(home, irrigation, municipal, industrial)

WELL COMPLETION DATA:

- (1) diameter (inches) 5"
- (2) total depth (feet) 220
- (3) static water level (feet) 50 below top of ground.
- (4) casing steel, 21'  
(material) (depth)
- (size) if telescope see back.
- (5) screen none  
(length) (depth to top)
- (size) (material)
- (6) pump none  
(HP) (yield gpm)
- (type power)
- (7) electric log no  
(yes or no)
- (organization running log)
- (8) how well bottom plugged

CODED


APR - 7 1969

DRILLERS REMARKS:

MISS. Bd. W.C.  
WATER WELL COMMISSIONERS

If well telescopes please sketch and show depths.

GROUND LEVEL

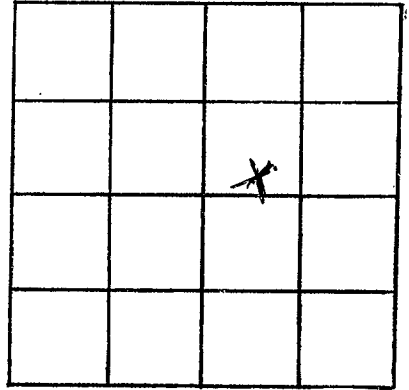

SECTION 20

Please indicate well location X.

ADDITIONAL INFORMATION

If more than one screen,  
show locations of each on sketch.