

PRENTISS

J 72

8-31-70

MISSISSIPPI BOARD OF WATER COMMISSIONERS 416 North State Street Jackson, Mississippi 39201

WATER WELL DRILLERS LOG

CODED

8-31

date well completed

1970 Bonch Well Drilling

firm name

Prentiss

county well located

LANDOWNER: B. K. Panell

description of formations encountered

from

to

Brownville Miss (mailing address)

Red clay
Blue clay
Water sand

0 16
16 338
338 390

WELL LOCATION:

sec 13 T 6 N R 5 E

6 miles west of Frank Johnson (distance) (direction) (nearest town)

WELL PURPOSE: Home (home, irrigation, municipal, industrial)

CODED

WELL COMPLETION DATA:

- (1) diameter (inches) 4
(2) total depth (feet) 390
(3) static water level (feet) 135 below top of ground.
(4) casing steel, 21 (material) (depth)

If telescope see back. (size)

(5) screen none (length) (depth to top)

(size) (material)

(6) pump 1/2 (HP) 4 (yield gpm)

Electric gas (type power)

(7) electric log no (yes or no)

(organization running log)

(8) how well bottom plugged open


SEP 9 1970

DRILLERS REMARKS:

MISS. BD. OF

If well telescopes please sketch and show depths.

GROUND LEVEL

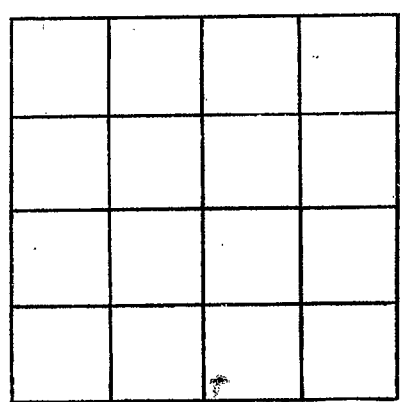

SECTION _____

Please indicate well location X.

ADDITIONAL INFORMATION

If more than one screen, show locations of each on sketch.