

PRENTISS
5732-B

Driller: James Fowler County: Prentiss
(Name)

8/22/69
CODED

(1) Owner of Land: Clyde Gardner
(Name)
Baldwyn, Miss.
(Address)
21 1/2 S 6E

(2) Location: 3 miles NW, of Baldwyn
(distance) (direction) (Nearest Town)

(3) Topography: Hilly
(Hilly) (Flat) (Level)

(4) Purpose of Well: Domestic
(Domestic Irrigation
Municipal, Industrial, Other)

Description & Color of Materials Sand, Clay, Red Clay, Shell, etc.	Thick- ness Feet	Depth Feet
<u>Sand</u>	<u>30</u>	
<u>Clay</u>	<u>118</u>	
<u>Sand</u>	<u>110</u>	

Information upon completion of well:

(1) Diameter 4" inches.

(2) Total Depth 278' feet.

(3) Water Level 40' feet below top of ground.


(4) Cased to 36', Size 4"

(5) Screen: Size _____, Length _____

(6) Were any formations sealed against pollution?
 yes, _____ no.

CODED

If YES depth of formation _____
Why to cut off deep zone
Drillers Remarks: Good Water

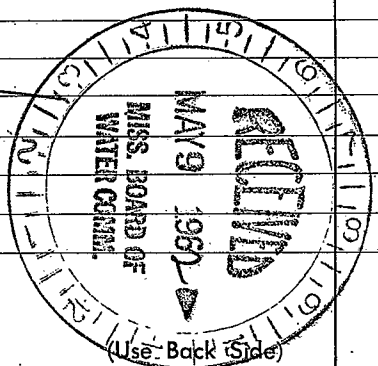

Well No.

