

PRENTISS

J-76

8-17-71

MISSISSIPPI  
 BOARD OF WATER COMMISSIONERS  
 416 North State Street  
 Jackson, Mississippi 39201

WATER WELL DRILLERS LOG

8-17

1971

Borch Well Drilling

firm name

Prentiss  
Mississippi

county well located

LANDOWNER: Queen Wallis

description of formations encountered

from

to

Brownville Miss  
(mailing address)

Red clay  
Blue clay  
Water sand

0 14  
14 252  
252 310

WELL LOCATION:

sec. 8 T. 6 N. R. 6 E  
10 miles south of Brownville  
(distance) (direction) (nearest town)

WELL PURPOSE: None  
(home, irrigation, municipal, industrial)

WELL COMPLETION DATA:

(1) diameter (inches) 4  
(2) total depth (feet) 300  
(3) static water level (feet) 90 below above  
top of ground.

(4) casing steel 21  
(material) (depth)

(size) if telescope see back.

(5) screen none  
(length) (depth to top)

(size) (material)

(6) pump hand on ground  
(HP) (type power)

(7) electric log no  
(yes or no)

(organization running log)

(8) how well bottom plugged open

**CODED**


SEP 20 1971

DRILLERS REMARKS:

MISS. BD. OF  
WATER COMMISSIONERS

If well telescopes please sketch and show depths.

GROUND LEVEL

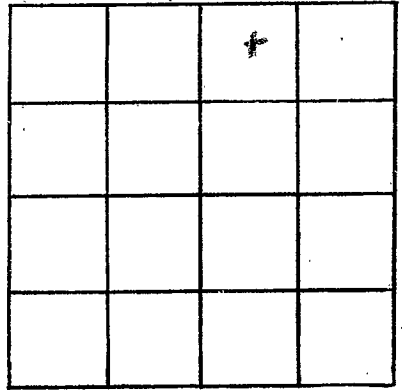

SECTION \_\_\_\_\_

Please indicate well location X.

ADDITIONAL INFORMATION

If more than one screen, show locations of each on sketch.