

MISSISSIPPI  
BOARD OF WATER COMMISSIONERS  
416 North State Street  
Jackson, Mississippi 39201

WATER WELL DRILLERS LOG

Prentiss  
J 281  
9-29-69

9-29 1969 Bonds Well Drilling Prentiss  
date well completed firm name county well located

LANDOWNER: Ray Hall  
R. 3  
Baldwin  
(mailing address)

description of formations encountered	from	to
	<u>Red sand</u>	<u>0</u>
<u>blue clay</u>	<u>35</u>	<u>340</u>
<u>Water sand</u>	<u>340</u>	<u>400</u>

WELL LOCATION:  
sec. 3 T. 6 N R. 6 E  
8 miles West of Franklin  
(distance) (direction) (nearest town)

WELL PURPOSE: Home  
(home, irrigation, municipal, industrial)

- WELL COMPLETION DATA:
- (1) diameter (inches) 4
  - (2) total depth (feet) 400
  - (3) static water level (feet) 160 <sup>below</sup> ~~above~~ top of ground.
  - (4) casing Steel 42  
(material) (depth)  
         if telescope see back.  
(size)
  - (5) screen None  
(length) (depth to top)  
         (size) (material)
  - (6) pump 2 4  
(HP) (yield gpm)  
Electric  
(type power)
  - (7) electric log no  
(yes or no)  
         (organization running log)
  - (8) how well bottom plugged open


OCT 3 - 1969

DRILLERS REMARKS:

MISS. Bd. of  
Water Comm.

If well telescopes please sketch and show depths.

GROUND LEVEL

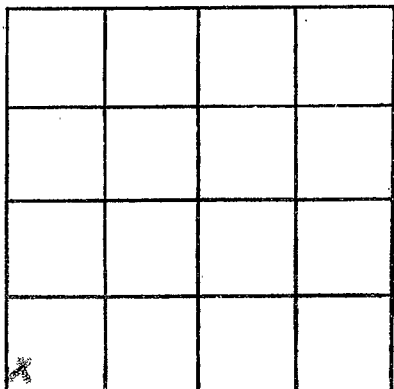

SECTION 3

Please indicate well location X.

ADDITIONAL INFORMATION

If more than one screen, show locations of each on sketch.