

PRENTISS
J 88
10-15-69

MISSISSIPPI
 BOARD OF WATER COMMISSIONERS
 416 North State Street
 Jackson, Mississippi 39201

CODED

WATER WELL DRILLERS LOG

10-15 1969 Bond Will Waller Prentiss
 date well completed firm name county well located

LANDOWNER: W. D. Waller
Booneville
 (mailing address)

description of formations encountered	depth	
	from	to
<u>Red clay</u>	<u>0</u>	<u>16</u>
<u>blue clay</u>	<u>16</u>	<u>290</u>
<u>Water sand</u>	<u>290</u>	<u>340</u>

WELL LOCATION:
 sec. 6 T. 6 N. R. 6 E.
5 miles West of Franktown
 (distance) (direction) (nearest town)

WELL PURPOSE: Home
 (home, irrigation, municipal, industrial)

- WELL COMPLETION DATA:
- (1) diameter (inches) 4
 - (2) total depth (feet) 340
 - (3) static water level (feet) 90 below above top of ground.
 - (4) casing Steel 21
 (material) (depth)
 (size) if telescope see back.
 - (5) screen None
 (length) (depth to top)
 (size) (material)
 - (6) pump Hand his on pump
 (HP) (yield gpm)
 (type power)
 - (7) electric log (yes or no)
 - (organization running log)
 - (8) how well bottom plugged None


NOV 20 1969

MISSISSIPPI
 BOARD OF WATER COMMISSIONERS
 JACKSON, MISSISSIPPI

DRILLERS REMARKS:

If well telescopes please sketch and show depths.

GROUND LEVEL

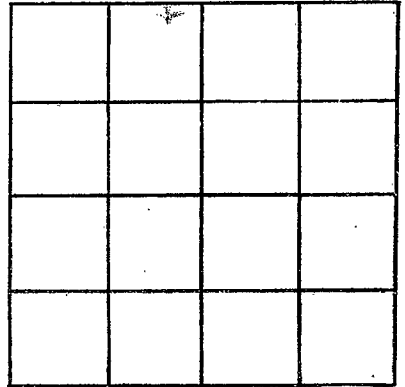

SECTION _____

Please indicate well location X.

ADDITIONAL INFORMATION

If more than one screen, show locations of each on sketch.