

*Prentiss*  
 83  
 11-25-69

MISSISSIPPI  
 BOARD OF WATER COMMISSIONERS  
 416 North State Street  
 Jackson, Mississippi 39201

CODED

WATER WELL DRILLERS LOG

11-25 1969 *Bonds Well Drilling Prentiss*  
 date well completed firm name county well located

LANDOWNER: *Robert Green*

description of formations encountered	depth	
	from	to
<i>Gravel sand</i>	0	35
<i>blue clay</i>	35	180
<i>water sand</i>	180	230

*Baldwin*  
 (mailing address)

WELL LOCATION:  
 sec. *33* T. *6* N. R. *6* E  
*4* miles <sup>S</sup> *W* of *Baldwin*  
 (distance) (direction) (nearest town)

WELL PURPOSE: *Home*  
 (home, irrigation, municipal, industrial)

WELL COMPLETION DATA:

- (1) diameter (inches) *4*
- (2) total depth (feet) *230*
- (3) static water level (feet) *35* below above top of ground.
- (4) casing *steel* *42*  
 (material) (depth)  
 (size) if telescope see back.
- (5) screen *none*  
 (length) (depth to top)  
 (size) (material)
- (6) pump *on pump*  
 (HP) (yield gpm)  
 (type power)
- (7) electric log *no*  
 (yes or no)  
 (organization running log)
- (8) how well bottom plugged *open*


DEC - 3 1969

DRILLERS REMARKS:

MISS. HD. OF  
 WATER COM.

If well telescopes please sketch and show depths.

GROUND LEVEL

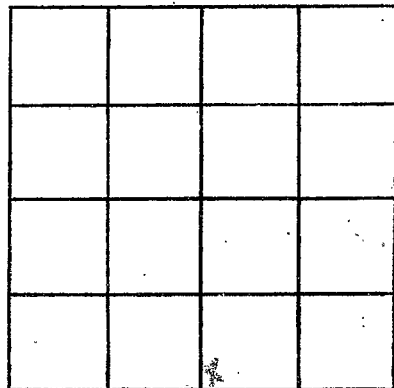

SECTION \_\_\_\_\_

Please indicate well location X.

ADDITIONAL INFORMATION

If more than one screen,  
show locations of each on sketch.