

CODED

J ~~10~~ 8A
7-16-63

WATER WELL DRILLERS LOG

Date: 7/16, 1963, Driller: HERNDON WELL & SUPPLY CO. County: Prentiss

(Name) HERNDON, MISSISSIPPI

| (1) Owner of Land | Description & Color of Materials Sand, Clay, Red Clay, Shell, etc. | Thick- ness Feet | Depth Feet |
|---|---|------------------------|---------------|
| <u>Baldwin Equipment Co.</u> (Name) <u>Baldwin, Miss.</u> (Address) | <u>surface sand</u> & <u>clay</u> | | <u>0</u> |
| (2) Location: <u>1/4</u> , <u>1/4</u> , Sec. <u>26</u> T. <u>6</u> R. <u>8E</u> <u>1</u> miles <u>N</u> , of <u>Baldwin</u> (distance) (direction) (Nearest Town) | <u>Blue rock</u> | | <u>155</u> |
| (3) Topography: <u>flat</u> (Hilly) (Flat) (Level) | <u>Sand</u> | | <u>300</u> |
| (4) Purpose of Well: <u>Domestic</u> (Domestic Irrigation Municipal, Industrial, Other) | <u>Bottom</u> | | <u>440</u> |


Information upon completion of well:

- (1) Diameter 4 inches.
- (2) Total Depth 440 feet.
- (3) Water Level 60 feet below top of ground.
- (4) Cased to 155', Size 4 1/2
- (5) Screen: Size , Length .
- (6) Were any formations sealed against pollution?
 yes, no.

If YES depth of formation 155'
Why surface & sand

Drillers Remarks:

CODED

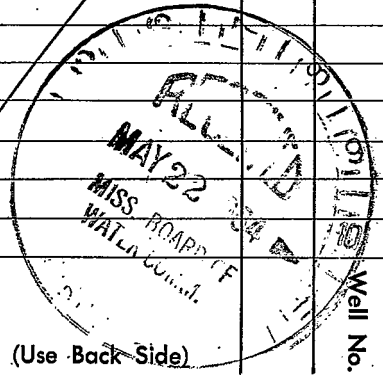

(Use Back Side)

Well No.

