

PRENTISS
J85
8-17-72

**MISSISSIPPI
 BOARD OF WATER COMMISSIONERS**
 416 North State Street
 Jackson, Mississippi 39201

CODED

WATER WELL DRILLERS LOG

8-17 1972 Bonds Well Drilling Prentiss
 date well completed firm name county well located

LANDOWNER: Leroy Tate

description of formations encountered	from	to

Boonerville
 (mailing address)

<u>Red clay</u>	<u>0</u>	<u>22</u>
<u>Blue clay</u>	<u>22</u>	<u>123</u>
<u>Blue sand</u>	<u>123</u>	<u>160</u>
<u>Blue clay</u>	<u>160</u>	<u>258</u>
<u>Water sand</u>	<u>258</u>	<u>300</u>

WELL LOCATION:
 sec. 9 T 6 N R 6 E
 S W
11 miles West of Franklin
 (distance) (direction) (nearest town)

WELL PURPOSE: Home
 (home, irrigation, municipal, industrial)

WELL COMPLETION DATA:

- (1) diameter (inches) 4
- (2) total depth (feet) 300
- (3) static water level (feet) 120 below above top of ground.
- (4) casing Steel 168
 (material) (depth)
 _____ if telescope see back.
 (size)
- (5) screen none
 (length) (depth to top)
 _____ (size) _____ (material)
- (6) pump 3 1/2 6
 (HP) (yield gpm)
Submersive
 (type power)
- (7) electric log no
 (yes or no)
 _____ (organization running log)
- (8) how well bottom plugged open

CODED


SEP 11 1972

MISS. BD. OF
 WATER COMMISSIONERS

DRILLERS REMARKS:

If well telescopes please sketch and show depths.

GROUND LEVEL

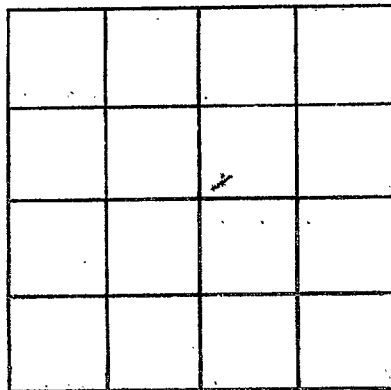

SECTION _____

Please indicate well location X.

ADDITIONAL INFORMATION

If more than one screen,
show locations of each on sketch.