

PRENTISS

J 86

8-29-72

MISSISSIPPI BOARD OF WATER COMMISSIONERS
416 North State Street
Jackson, Mississippi 39201

CODED

WATER WELL DRILLERS LOG

8-29
date well completed

1972 Bonds Well Drilling
firm name

Prentiss
county well located

LANDOWNER: Ben Armas

description of formations encountered

from

to

Baldwyn
(mailing address)

Red Clay 0 36
Blue Clay 36 395
Water sand 395 440

WELL LOCATION:

sec. 21 T. 6 N R. 6 E
S W
4 miles West of Baldwyn
(distance) (direction) (nearest town)

WELL PURPOSE: Home
(home, irrigation, municipal, industrial)

WELL COMPLETION DATA:

- (1) diameter (inches) 4
- (2) total depth (feet) 440
- (3) static water level (feet) 124 below above top of ground.
- (4) casing Steel 42
(material) (depth)

_____ if telescope see back.
(size)

- (5) screen none
(length) (depth to top)

_____ (size) (material)

- (6) pump 2 5
(HP) (yield gpm)

Get pump
(type power)

- (7) electric log no
(yes or no)

_____ (organization running log)

- (8) how well bottom plugged open

DRILLERS REMARKS:


CODED

SEP 11 1972

MISSISSIPPI BOARD OF WATER COMMISSIONERS

If well telescopes please sketch and show depths.

GROUND LEVEL

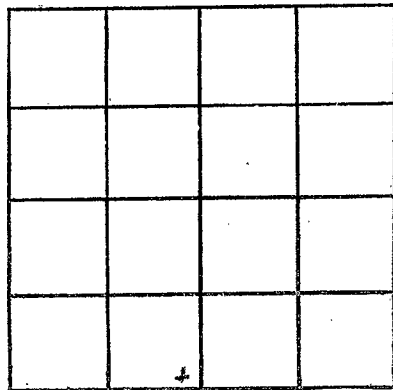

SECTION _____

Please indicate well location X.

ADDITIONAL INFORMATION

If more than one screen, show locations of each on sketch.