

PRENTISS

J 87

7-23-73

MISSISSIPPI BOARD OF WATER COMMISSIONERS  
416 North State Street  
Jackson, Mississippi 39201

**CODED**

WATER WELL DRILLERS LOG

Herman Homan Well & Supply, Inc.  
P. O. Box 42

Prentiss

6-20 1973  
date well completed

SHANNON MISSISSIPPI 38868  
firm name

county well located

LANDOWNER:

W.W. Copeland  
Balderson, Miss.  
(mailing address)

description of formations encountered

from to

Surface sand & clay 0 170  
Blue clay 170 280  
Sandy 280 420  
Bottom 420

WELL LOCATION:

sec. 26 6 N R. 6 E  
S W  
3/4 miles N of Balderson  
(distance) (direction) (nearest town)

WELL PURPOSE:

Home  
(home, irrigation, municipal, industrial)

WELL COMPLETION DATA:

- (1) diameter (inches) 4"
- (2) total depth (feet) 420'
- (3) static water level (feet) 85' below top of ground.
- (4) casing steel, 177' 10" (material) (depth)  
4" (size) if telescope see back.
- (5) screen ND (length) (depth to top)  
(size) (material)
- (6) pump 3/4 HP, 10 (yield gpm)  
electric (type power)
- (7) electric log ND (yes or no)  
(organization running log)
- (8) how well bottom plugged open


**CODED**

DRILLERS REMARKS:

JUL 18 1973

If well telescopes please  
sketch and show depths.

GROUND LEVEL

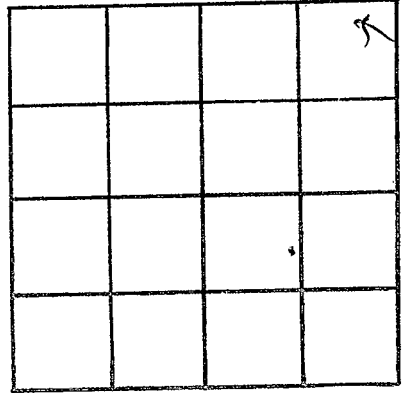

SECTION 26

Please indicate well location X.

ADDITIONAL INFORMATION

If more than one screen,  
show locations of each on sketch.